

**NARRATIVE:**

The purpose of this survey is to locate the North and West lines of a parcel described in a deed to AA INVESTMENTS, recorded on Reel 76, Page 154, Umatilla County Deed Records (Tax Lot 402).

I had surveyed those lines in a combination of three surveys in the mid seventies. In this survey I tied them all together and set the Southwest corner of said parcel which had never been set.


REGISTERED  
PROFESSIONAL  
LAND SURVEYOR

*G. Dennis Edwards*

OREGON  
JULY 16, 1971  
G. DENNIS EDWARDS  
951  
RENEWS 12/31/97

**LEGEND:**

- Found 1/2" rebar set by Me:
  - (A) April 1978 survey for AEF. Manufacturing.
  - (B) January 1978 survey for Starrett.
  - (C) 1976, Revised in 1977 for Dack - Starrett.
- ⊙ Found 5/8" rebar with plastic cap #951, Me, 1995 survey for Lopez.
- Set 5/8" x 30" rebar with plastic cap #951.
- (ooo) of Record. My 1970's surveys.
- [ooo] of Record. Deed.

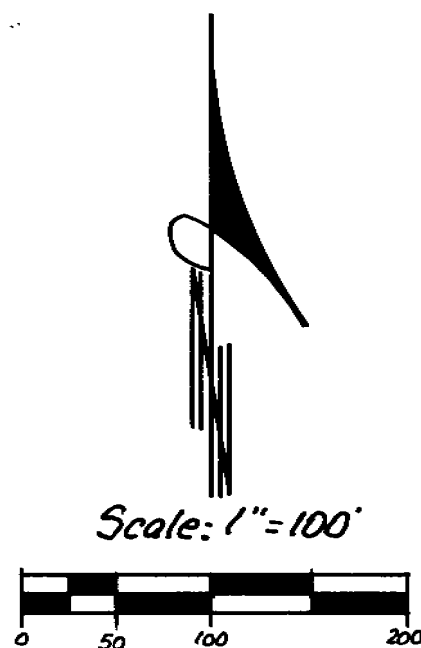

RECEIVED BY  
Umatilla County Surveyor  
Date 5-97  
Made by KK  
No. 97-93-A

Survey for DON ARMSTRONG  
In NW 1/4 Section 34, T5N, R28E, W.M.,  
Umatilla County, Oregon  
4/16/97 Job #59704072  
Edwards Surveying P.O. Box 763  
541-567-3336 Hermiston, Oregon 97838

97-93-A