


NARRATIVE:

The purpose of this survey is to stake the corners of the South half of Lot 13, Block 14, "NEWPORT ADDITION" to the City of Hermiston, so a manufactured home can be sited. I had computed the SE corner of Lot 13, in a 1994 survey for Anderson. Said corner is also the SW corner of "ANDERSON MINI ESTATES". I used that 1994 survey and one for Deck in Block 15, done in 1994, to establish the corners of said lot 13. My dimensions for this lot match the dimension of the original 1908 Plat of "NEWPORT ADDITION."

REGISTERED
PROFESSIONAL
LAND SURVEYOR

G. Dennis Edwards

OREGON
JULY 16, 1971
G. DENNIS EDWARDS
951
RENEWS 12/31/97

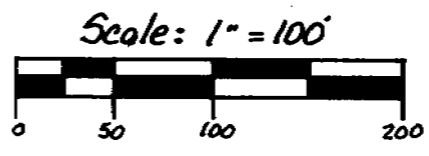

RECEIVED BY
Umatilla County Surveyor
Date 8-97
Rec'd By KK
No. 97-164-A

LEGEND:

- ⊕ Found 5/8" Iron Rod in Monument Box. Origin unknown.
- Found 5/8" rebar with plastic cap *951. Me, May 1994 Survey for Anderson, unless noted otherwise.
- Set 5/8" x 30" rebar with plastic cap *951.
- (000) of Record. 1908 Plat of "NEWPORT ADDITION."
- [000] of Record. My 1994 survey for Gus Anderson.

Survey for ANITA MOSQUEDA c/o UNIVERSAL REALTY
In Block 14, "NEWPORT ADDITION" to the
City of Hermiston, Umatilla County, Oregon
In the SW 1/4 of Section 11, T4N, R28E, W.M.
6/20/97 Job #S9706140
Edwards Surveying P.O. Box 763
541-567-3336 Hermiston, Oregon 97838

97-164-A