

NARRATIVE:

THE PURPOSE OF THIS SURVEY IS SET THE CORNERS OF LOT 3, BLOCK 3, "PETERSON ADDITION" TO SEE WHERE A FENCE AND CONCRETE RETAINING WALL LIE IN RELATION TO THE LOT LINES.

TO SET THESE CORNERS I RETRACED ASCHER'S 1965 PLAT OF "PETERSON ADDITION" FROM FOUND CENTER LINE MONUMENTS AND FROM MONUMENTS I SET FOR TOM DAVIS AND ME IN BLOCK 2.


REGISTERED
PROFESSIONAL
LAND SURVEYOR

G. Dennis Edwards

OREGON
JULY 16, 1971
G. DENNIS EDWARDS
9 5 1
RENEWS 12/31/2001

LEGEND:

- FOUND MONUMENT AS NOTED
- SET 5/8"X30" IRON REBAR WITH PLASTIC CAP #951
- (000) OF RECORD, ASCHER 1965 PLAT OF "PETERSON ADDITION"

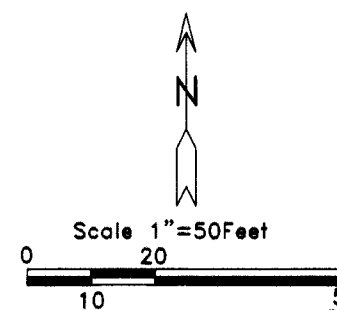

SURVEY FOR DOY LEHMAN
IN LOT 3, BLK. 3, "PETERSON ADDITION",
SE 1/4, SEC. 18, T 5 N, R 28 E, W.M.,
CITY OF UMATILLA, UMATILLA COUNTY, OREGON
8/28/2001 JOB# S0108270
EDWARDS SURVEYING P.O. BOX 763
541-567-3336 HERMISTON, OREGON 97838
DRAWN BY NJF

RECEIVED BY
Umatilla County Surveyor
Date 12-01
Rec'd by KR
No. 01-190-A

01-190-A