

**NARRATIVE:**

THE PURPOSE OF THIS SURVEY IS TO STAKE THE PROPERTY OF CHRISTINE COON DESCRIBED ON REEL 394 PAGE 93 SO A FENCE CAN BE BUILT. I SURVEYED THE NORTH AND WEST LINE OF THIS TRACT IN A 1976 SURVEY FOR COTTRILL. I SURVEYED PART OF THE SOUTH LINE IN A 1984 SURVEY FOR FIRST INTERSTATE BANK. THOSE SURVEYS WERE BASED ON WALLULIS' SUBDIVISION OF THE NW 1/4 OF SECTION 10 IN A 1968 SURVEY. COON'S DEED HAS MANY ERRORS AND CAN NOT BE SURVEYED FROM THE DEED. I SET HER CORNERS FROM ADJOINING DEEDS WHICH ARE SENIOR TO HERS. I HAVE CONTACTED PIONEER TITLE TO INITIATE A CORRECTION DEED TO MAKE COON'S DEED MATCH HER ADJOINERS.


REGISTERED  
PROFESSIONAL  
LAND SURVEYOR

*G. Dennis Edwards*

OREGON  
JULY 16, 1971  
G. DENNIS EDWARDS  
9 5 1  
RENEWS 12/31/2003

**LEGEND:**

- 1/2" IRON REBAR FOUND AS NOTED
- SET 5/8"x30" IRON REBAR WITH PLASTIC CAP #951
- [000] OF RECORD, MY 1976 SURVEY FOR COTTRILL
- (000) OF RECORD, MY 1984 SURVEY FOR 1ST INTERSTATE BANK, OR AS NOTED.

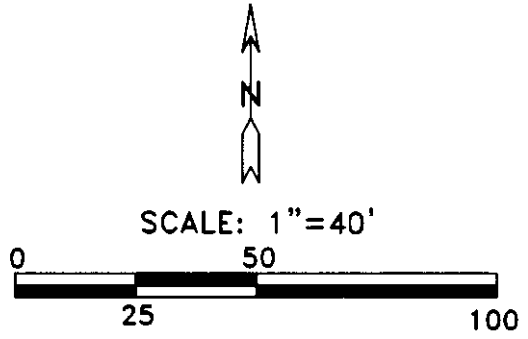

SURVEY FOR CHRISTINE COONS  
IN NW 1/4, SEC. 10, T 4 N, R 28 E,  
W.M., UMATILLA COUNTY, OREGON  
6/19/02 JOB# S0206141  
EDWARDS SURVEYING P.O. BOX 763  
541-567-3336 HERMISTON, OREGON 97838  
DRAWN BY NJF

RECEIVED BY  
Umatilla County Surveyor  
Date 8-02  
Rec'd By KK  
No. 02-199-A

02-199-A