


BEARINGS BASED ON WORK
 DONE BY KRUMBIEN. ENG'R CO.
 MARCH 1976

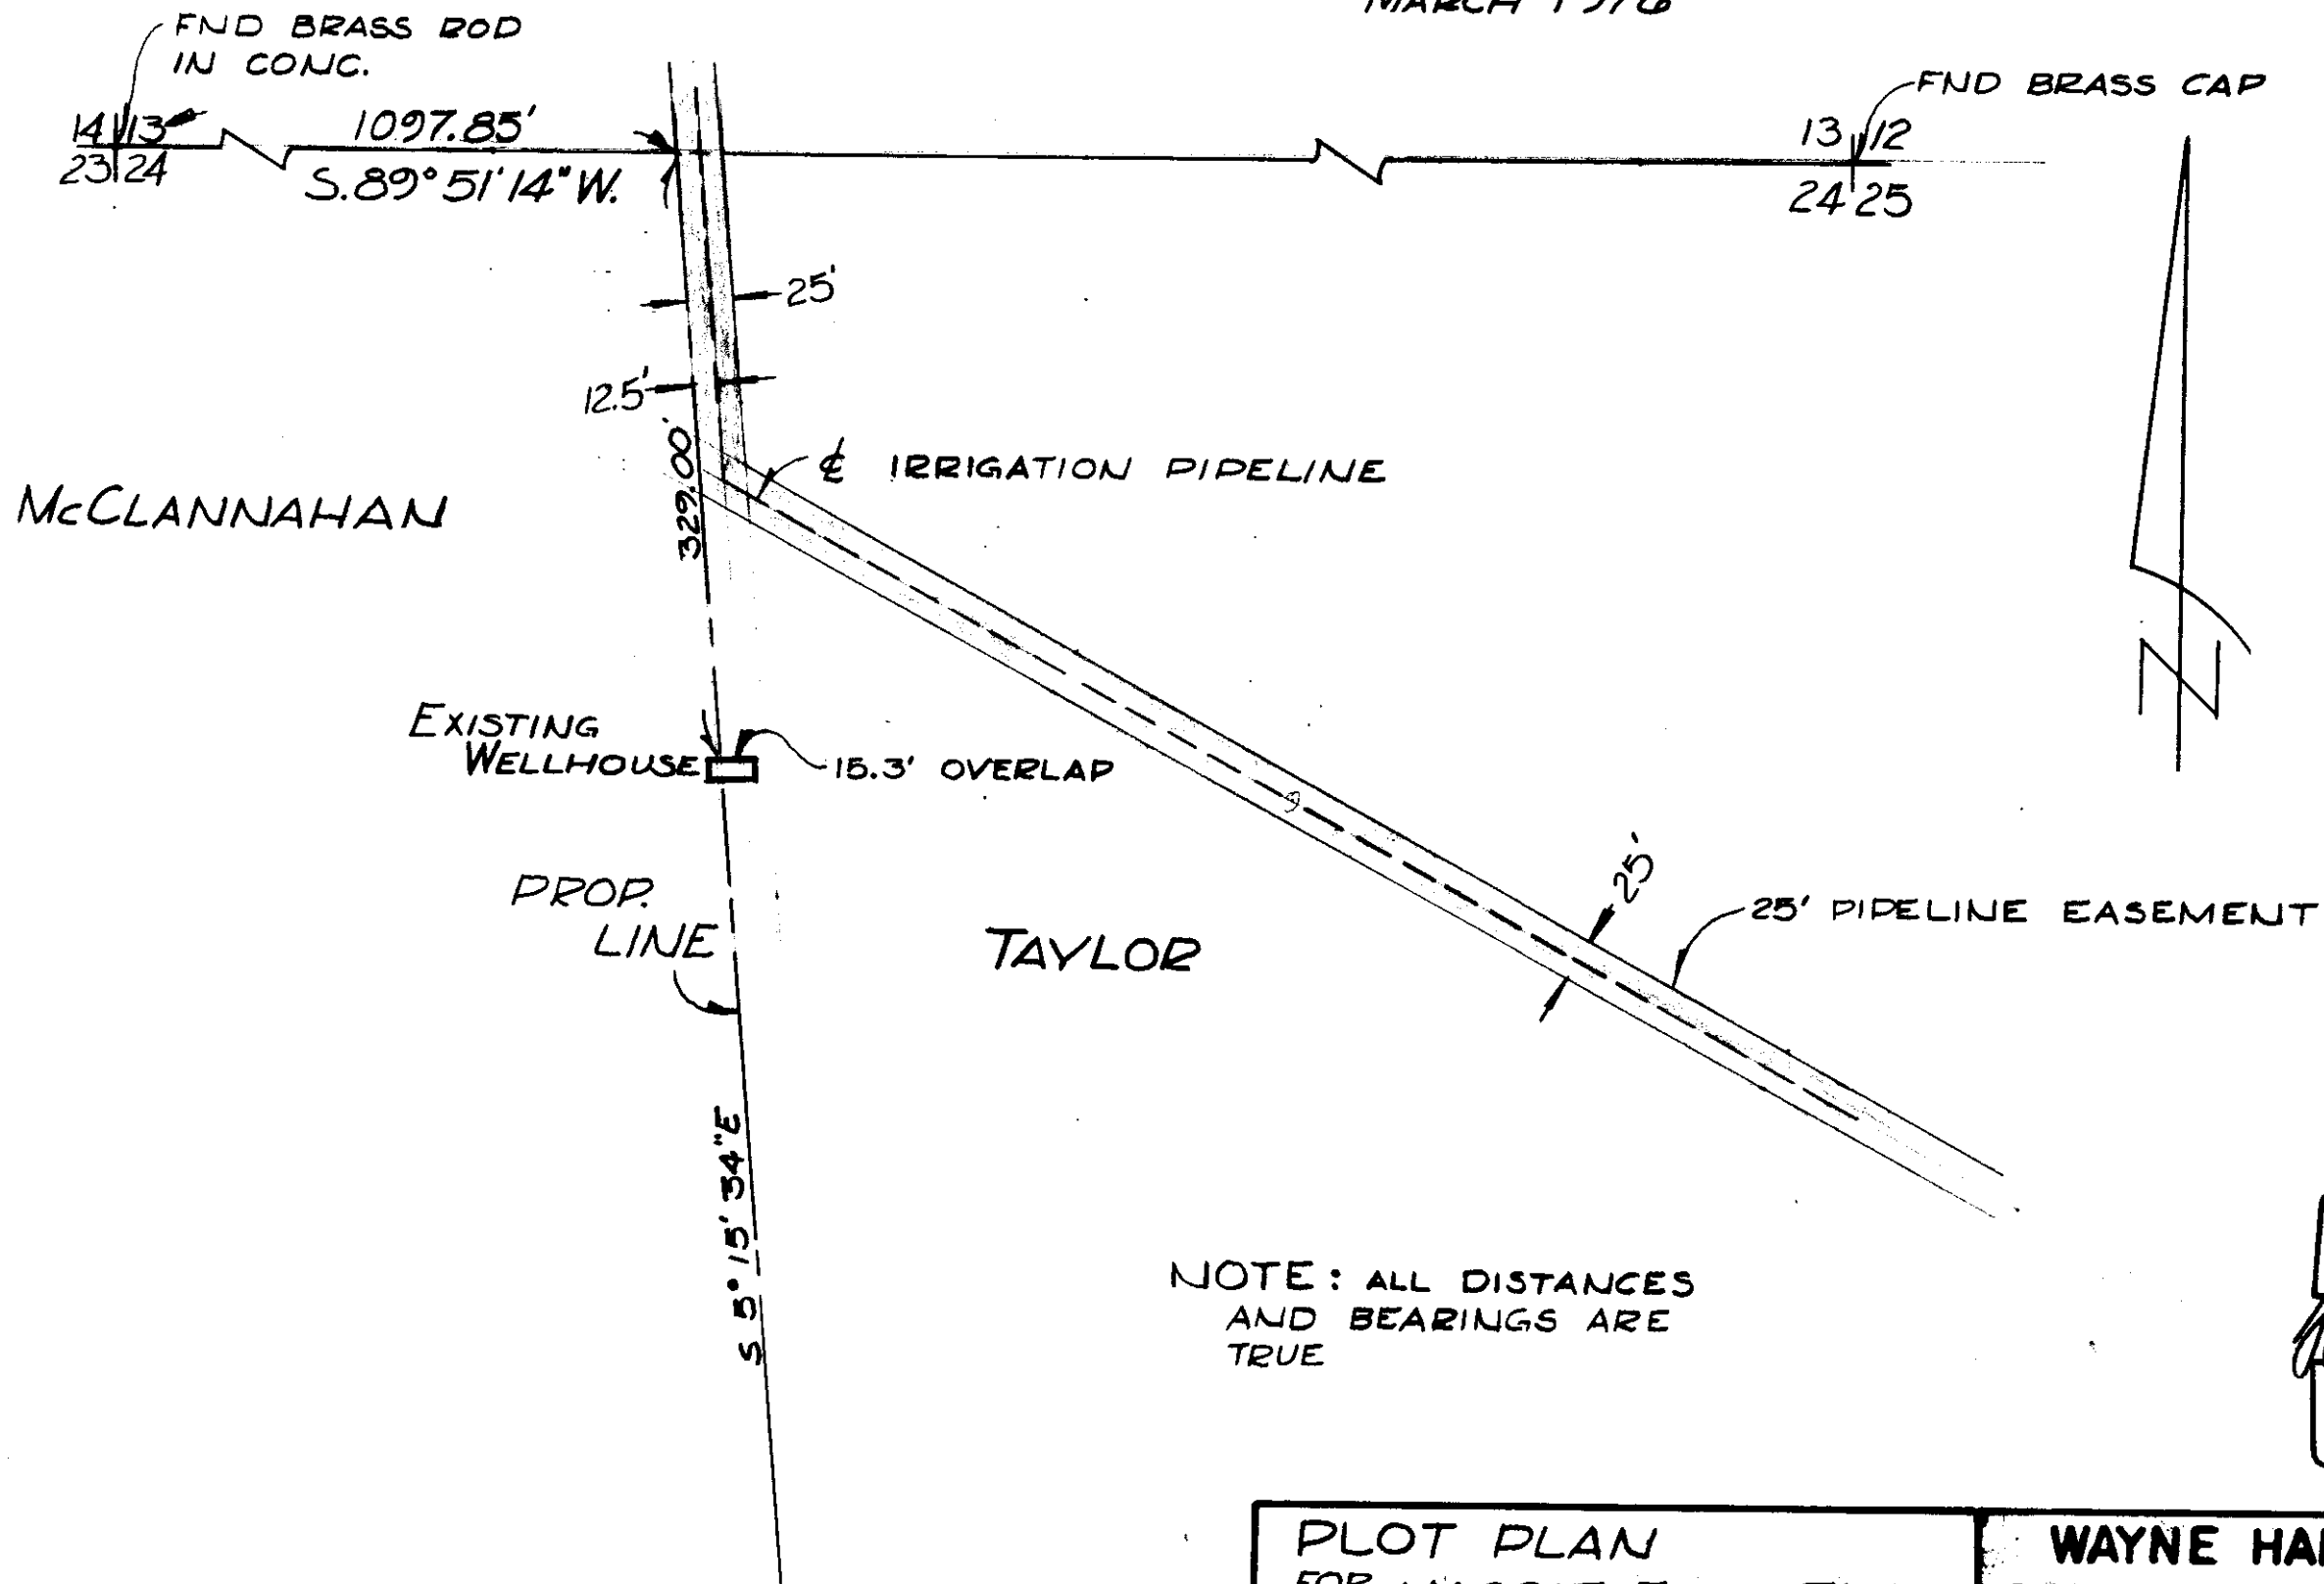

NOTE: ALL DISTANCES
 AND BEARINGS ARE
 TRUE

REGISTERED
 PROFESSIONAL
 LAND SURVEYOR
 OREGON
 MAY 6, 1955
 WAYNE O. HARRIS
 346

PLOT PLAN FOR MAGGIE JUNE TAYLOR N 1/2, NW 1/4, NW 1/4, SEC 24 T5N R27E W.M.		WAYNE HARRIS CO. INC. ENGINEERS - SURVEYORS PENDLETON, ORE				
SCALE	DATE	DWN	CHK	DWG. NO.		
1" = 100'	4-25-78	IGD		78-41A		

02-242-A

02-242-A