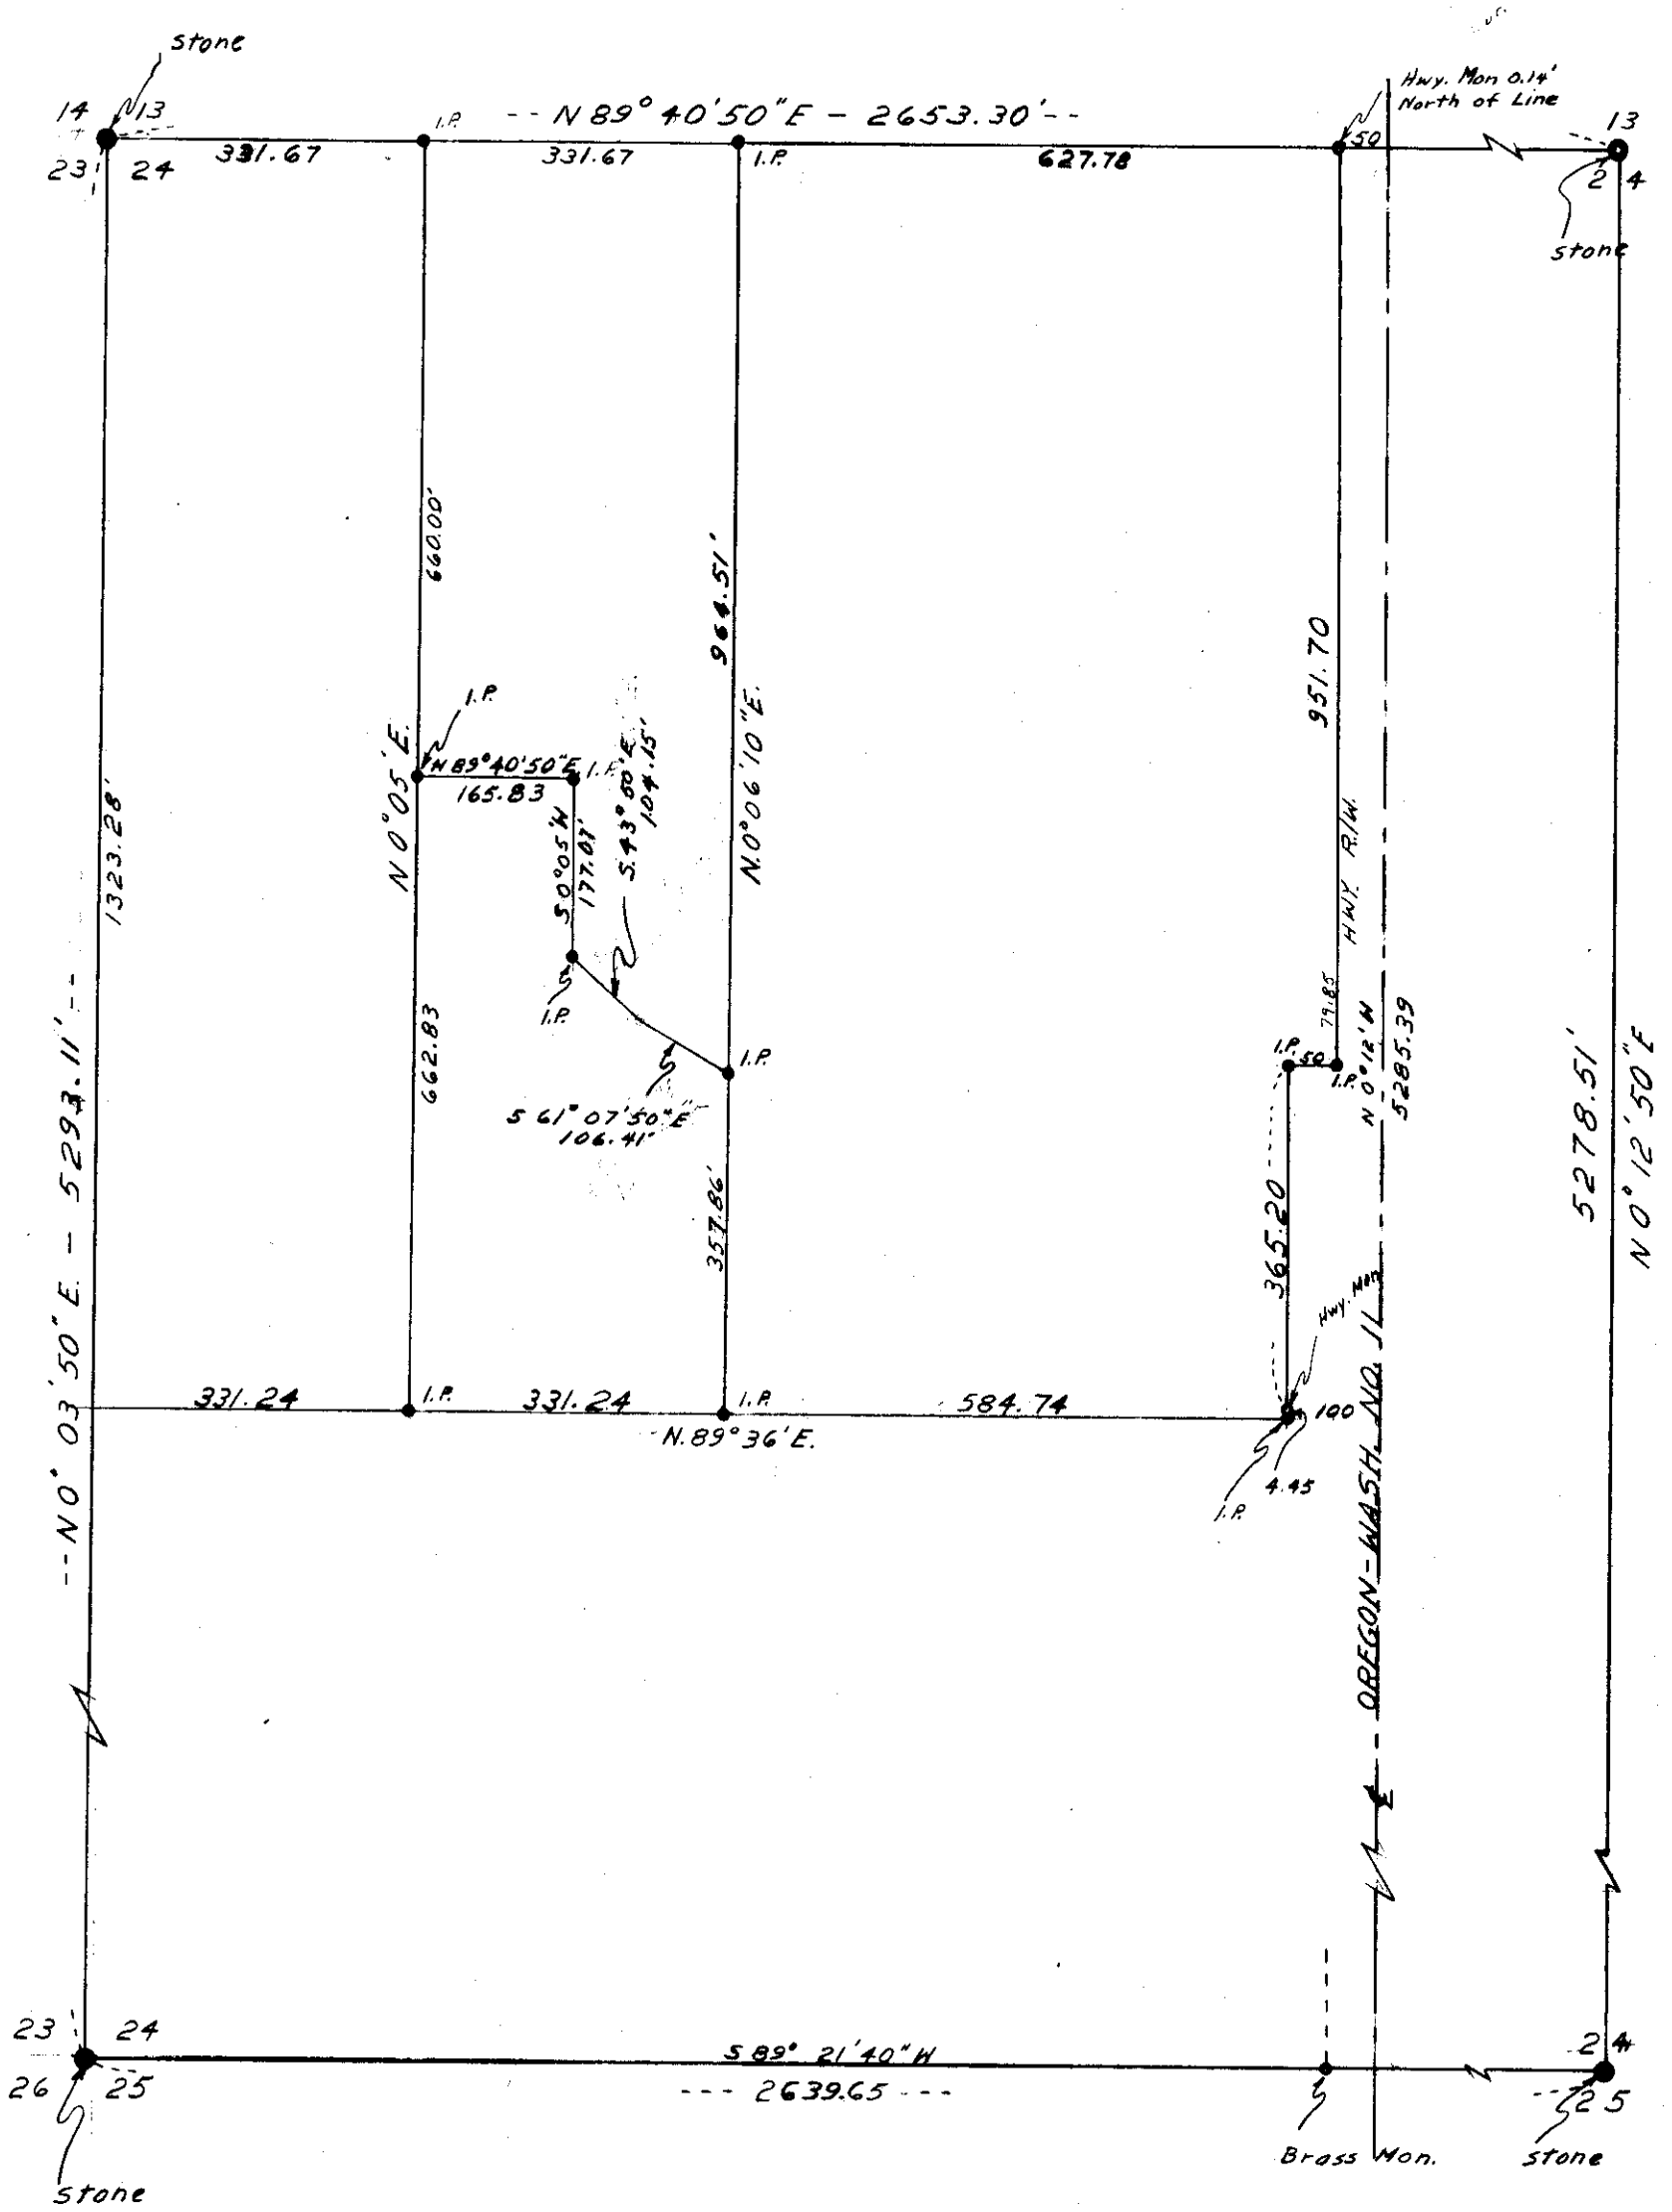

REGISTERED
OREGON
LAND SURVEYOR

Wayne O. Harris

MAY 6, 1955
WAYNE O. HARRIS
346

HAYES AND HARRIS

Survey For

E.F. ARNOLD & MRS. F.B. BROWN

Parcel in NW¼, Sec. 24
T. ~~5~~ 6 N., R. ~~36~~ 35 E., W.M.

Scale	Date	Drn. By	Drng. No.
1"-200'	11/13/57	W.O.H.	57-62A

03-188-A

03-188-A

57-62A