

NARRATIVE:


THE PURPOSE OF THIS SURVEY IS TO SEE WHICH OF THE SOUTH CORNERS OF LOT 15 IS INCORRECT SO A FENCE CAN BE CONSTRUCTED ALONG THE EAST LINE OF SAID LOT 15. I FOUND THREE ORIGINAL MONUMENTS OF "COTTONWOOD ESTATES" AND RETRACED THE PLAT TO FIND THAT THE MONUMENT AT THE SE CORNER IS CORRECT AND THE MONUMENT AT THE SW CORNER, SET BY KRUMBEIN IN 1984 FOR LANDON, WAS EITHER SET WRONG OR WAS MOVED. I SET A NAIL IN THE CONCRETE FOOTING OF A FENCE FOR THE SW CORNER OF LOT 15.

REGISTERED
PROFESSIONAL
LAND SURVEYOR

G. Dennis Edwards

OREGON
JULY 16, 1971
G. DENNIS EDWARDS
9 5 1
RENEWS 12/31/2005

- LEGEND:**
- MONUMENTS FOUND AS NOTED
 - SET 5/8"X30" IRON REBAR WITH PLASTIC CAP #951
 - (000) OF RECORD, PLAT OF "COTTON WOOD ESTATES"
 - ⊙ SET CONC. NAIL

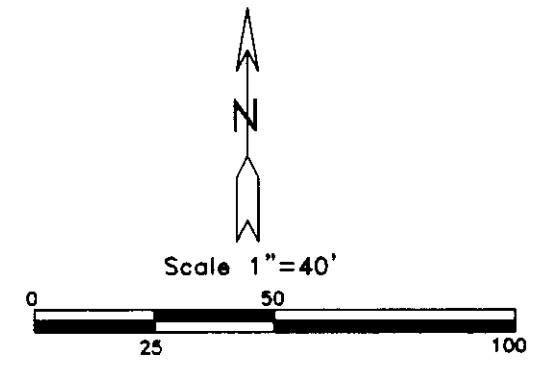

SURVEY FOR DOUG BARAK
IN LOT 15, BLK. 1, "COTTON WOOD ESTATES",
IN NE 1/4, NW 1/4, SEC. 14, T 4 N, R 28 E,
W.M., UMATILLA COUNTY, OREGON
6/4/2004 JOB# S0406107
EDWARDS SURVEYING P.O. BOX 763
541-567-3336 HERMISTON, OREGON 97838
DRAWN BY NJF

RECEIVED BY
Umatilla County Surveyor
Date 8-04
Rec'd By KK
No. 04-150-A

04-150-A