

**NARRATIVE:**

THE PURPOSE OF THIS SURVEY IS TO SET THE FOUR CORNERS OF LOTS 4 AND 5, BLOCK 6, "BROWNELL'S ADD." TO THE CITY OF UMATILLA, SO PROPER SETBACKS CAN BE ESTABLISHED FOR NEW CONSTRUCTION.


I RETRACED CRIGER'S 1944 PLAT OF "BROWNELL'S ADD." FROM THE FOUND MONUMENTS TO ESTABLISH THE FOUR CORNERS WHICH I SET. THOSE FOUND MONUMENTS COULD BE HIS OR COULD HAVE BEEN SET BY OTHER SURVEYORS.

A SOKKIA SET 300 TOTAL STATION WAS USED TO TIE THE EXISTING MONUMENTS AND THEIR LOCATIONS WERE CONFIRMED FROM PREVIOUS SURVEYS BY ME.


REGISTERED  
 PROFESSIONAL  
 LAND SURVEYOR

*G. Dennis Edwards*

OREGON  
 JULY 16, 1971  
 G. DENNIS EDWARDS  
 9 5 1  
 RENEWS 12/31/2007

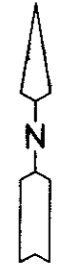

SCALE: 1"=50'

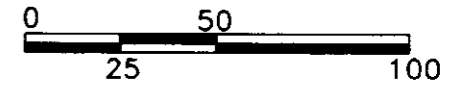

SURVEY FOR MATT JOHNSON  
 IN BLK 6 "BROWNELL'S ADD.,"  
 TO CITY OF UMATILLA IN NE 1/4, SEC 17,  
 T 5 N, R 28 E, W.M., UMATILLA CO., OREGON  
 01/11/2006 JOB# S0601003  
 EDWARDS SURVEYING P.O. BOX 763  
 541-567-3336 HERMISTON, OREGON 97838  
 DRAWN BY JMC  
 CHECKED BY

Umatilla County Surveyor

Date 5-06

Rec'd By KK

No. 06-201-A