

NARRATIVE:

THE PURPOSE OF THIS SURVEY IS TO STAKE THE CORNERS OF BLOCK 15 "McNARY ADD." SO A FENCE CAN BE BUILT.

I RETRACED TALBOT'S ORIGINAL PLAT TO ESTABLISH THE CORNERS OF SAID BLOCK 15. THE BEARINGS ARE BASED ON THE ORIGINAL PLAT, BK. 6, PAGES 18 & 19.

DATA WAS COLLECTED WITH A TOPCON HIPER + GPS.


REGISTERED
PROFESSIONAL
LAND SURVEYOR

G. Dennis Edwards

OREGON
JULY 16, 1971
G. DENNIS EDWARDS
951
RENEWS 12/31/2007



SCALE: 1"=100'

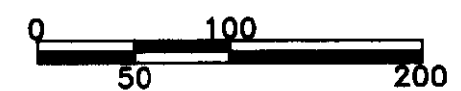

LEGEND:

- FOUND MONUMENTS AS NOTED
- SET 5/8"X30" IRON REBAR WITH PLASTIC CAP #951
- △ SET RR SPIKE STAMPED 951
- ⊙ COMPUTED LOCATION
- (000) OF RECORD, TALBOT'S PLAT OF "McNARY ADD.," BOOK 6, PAGES 18 & 19

SURVEY FOR WALT REID
IN BLOCK 15 McNARY ADD., IN SE 1/4 SEC. 8
& NE 1/4 SEC. 17, T 5 N, R 28 E, W.M.,
CITY OF UMATILLA, UMATILLA COUNTY, OREGON
08/23/2006 JOB #S0608114
EDWARDS SURVEYING P.O. BOX 763
541-567-3336 HERMISTON, OREGON 97838
DRAWN BY JMC

RECEIVED BY

Umatilla County Surveyor

Date 01-07

Rec'd by KK

No. 07-001-A