

NARRATIVE:


THE PURPOSE OF THIS SURVEY IS TO MONUMENT THE CORNERS OF THAT TRACT OF LAND DEEDED TO THE HERMISTON FIRST CHURCH OF THE NAZARENE ON REEL 142, PAGE 36, REEL 142, PAGE 38, AND ON REEL 141, PAGE 1833. EXCEPTING THAT TRACT DEEDED TO L. LAGIER ON REEL 141, PAGE 1834, SO A FENCE CAN BE BUILT.

I SURVEYED THE WEST LINE OF THIS TRACT IN A 1986 SURVEY FOR L. LAGIER. I SUBDIVIDED THE SE 1/4 OF SECTION 9 IN A 2005 SURVEY FOR CHOWNING AND THIS SURVEY AND THE BEARINGS ARE BASED ON THAT 2005 SURVEY.

REGISTERED
PROFESSIONAL
LAND SURVEYOR

G. Dennis Edwards

OREGON
JULY 16, 1971
G. DENNIS EDWARDS
951
RENEWS 12/31/2007

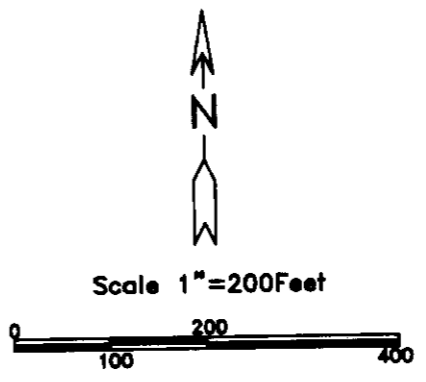

- LEGEND:**
- MONUMENTS FOUND AS NOTED, OR AS BELOW
 - Ⓐ 5/8" 1978 LAGIER SURVEY FOR LAGIER
 - Ⓑ 1/2" 1986 EDWARDS SURVEY FOR LAGIER
 - Ⓒ 5/8" 2005 EDWARDS SURVEY FOR CHOWNING
 - SET 5/8"x30" IRON REBAR WITH PLASTIC CAP #951
 - ⊙ COMPUTED LOCATION

SURVEY FOR NAZARENE CHURCH
IN SE 1/4, SEC. 9, T 4 N, R 28 E,
W.M., UMATILLA COUNTY, OREGON
07/15/2006 JOB# S0606107
EDWARDS SURVEYING P.O. BOX 763
541-567-3336 HERMISTON, OREGON 97838
DRAWN BY JMC

RECEIVED BY

Umatilla County Surveyor

Date 01-07

Drawn by KK

No. 07-002-A