

LINE TABLE:

L-1	N 67°48'28" W 265.61'
L-2	N 6°30'35" W 119.75'
L-3	N 11°08'18" W 125.16'
L-4	N 52°23'41" W 197.63'
L-5	N 39°20'52" W 36.34'

NARRATIVE:

THE PURPOSE OF THIS SURVEY IS TO STAKE THAT PORTION OF THE NE 1/4 OF THE NW 1/4 OF THE NE 1/4 OF SECTION 16, T 4 N, R 28 E, WILLAMETTE MERIDIAN, UMATILLA COUNTY, OREGON, WHICH LIES NORTHEASTERLY OF THE CENTER LINE OF THE "I" CANAL SO A SUBDIVISION CAN BE DEVELOPED.

THE "I" CANAL IS NOW IN A PVC PIPE LINE WHICH WAS INSTALLED IN THE APPROXIMATE LOCATION OF THE CANAL. I CONSULTED WITH THE MANAGER OF THE HERMISTON IRRIGATION DISTRICT, JEREMY BOLEN, TO ESTABLISH THE LOCATION OF SAID "I" LINE.

THIS SURVEY WAS CONDUCTED WITH A TOPCON HIPER + G.P.S..

REGISTERED
PROFESSIONAL
LAND SURVEYOR

G. Dennis Edwards

OREGON
JULY 16, 1971
G. DENNIS EDWARDS
9 5 1

RENEWS 12/31/2013

RECEIVED BY


Umatilla County Surveyor
Date: 5/10/2013
Rec'd By: S. Alex
No.: 13-147-A

SURVEY FOR TOM LONGLEY (CASTLE HOMES)
IN NW 1/4, NE 1/4, SEC. 16, T 4 N,
R 28 E, W.M., UMATILLA COUNTY, OREGON
03/25/2013 JOB# S1302012A
EDWARDS SURVEYING P.O. BOX 763
541-567-3336 HERMISTON, OREGON 97838
DRAWN BY JMC

N 85°42'48" E 1.70'
FND. 3/4" I. REBAR,
COR. SEC. 16
MAD. SEC. 9
N 79°28'19" E
E 8502493.49
R.R. SPIKE USED
FOR N 1/4 COR. SEC. 16
SHOWN ON MY MAP 10, 2004
G.I.S. SURVEY FOR UMATILLA COUNTY

BEARING BASE MY 2010 SURVEY FOR MAKAMI BROS.
N 0°04'04" W 1326.10' (1326.18')
630.05' (630.09')
663.05' (663.09')

FND. 2 1/2" B.C.,
C-N 1/16 SEC. 16
SHOWN ON MY MAP 10,
2004 G.I.S. SURVEY FOR
UMATILLA COUNTY

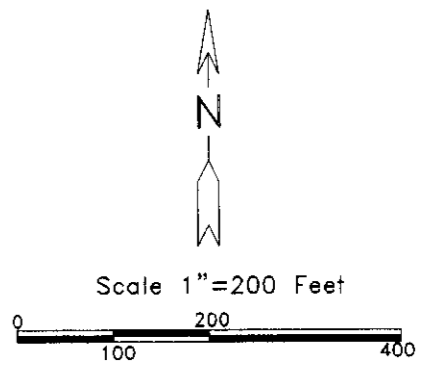

- LEGEND:**
- FOUND 5/8" I. REBAR WITH PLASTIC CAP #951, MY 2010 SURVEY FOR MAKAMI BROS., UNLESS NOTED OTHERWISE
 - SET 5/8"X30" IRON REBAR WITH PLASTIC CAP #951
 - ⊙ COMPUTED LOCATION
- (000) OF RECORD, MY 2010 SURVEY FOR MAKAMI BROS.