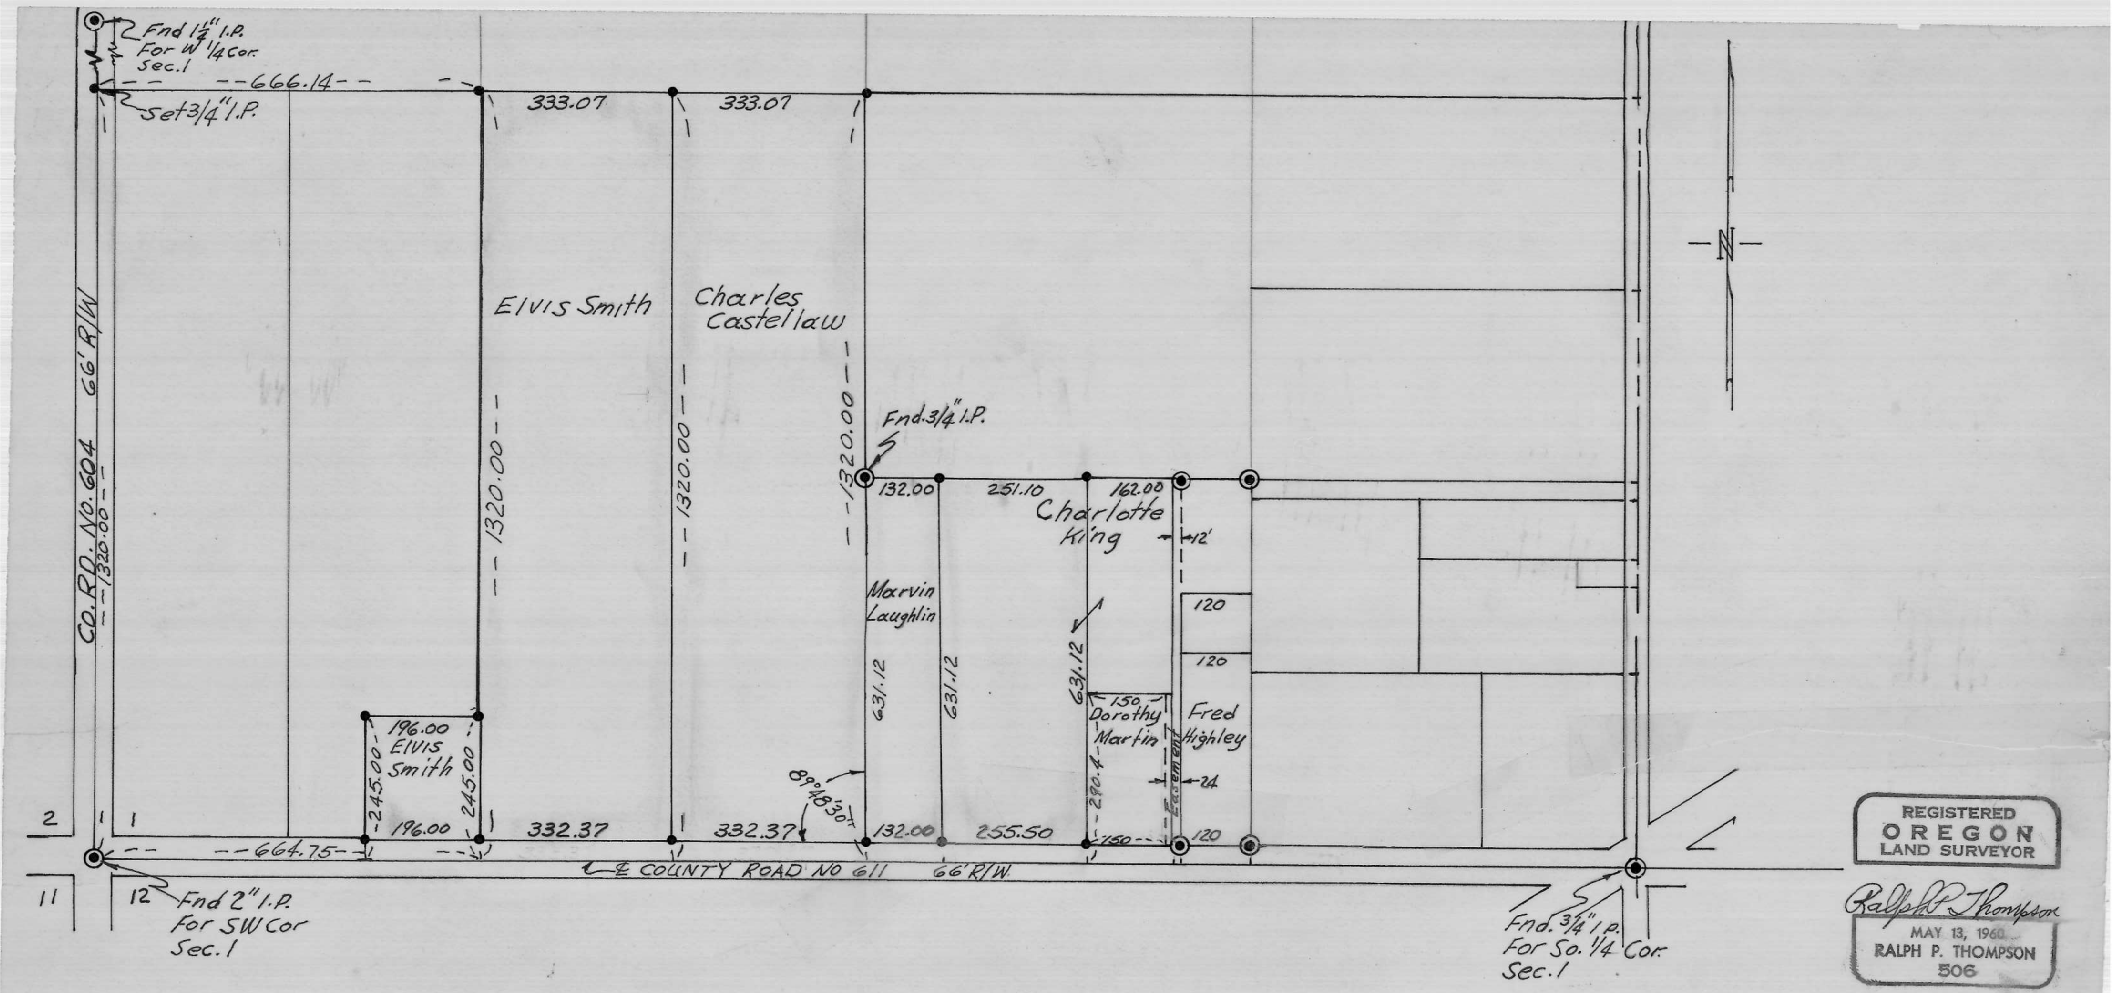

REGISTERED
OREGON
LAND SURVEYOR

Ralph P. Thompson

MAY 13, 1960
RALPH P. THOMPSON
506

"◉" Indicates Monuments Found
"●" Indicates Property Corners Set – ½" x 24" I.P.'s

Property Surveys
AS SHOWN
In S.W. ¼ Sec. 1, T. 4 N. R. 28 E. W. M.
Date: 3-23-64 | Scale: 1" = 20'

R. P. THOMPSON
REGISTERED PROFESSIONAL LAND SURVEYOR
13 S. E. COURT AVE. PENDLETON, OREGON

B-3-A

B-3