


B-5-A

FOUND  
CENTER SEC. 10  
T. 4 N., R. 28 E., W. 4

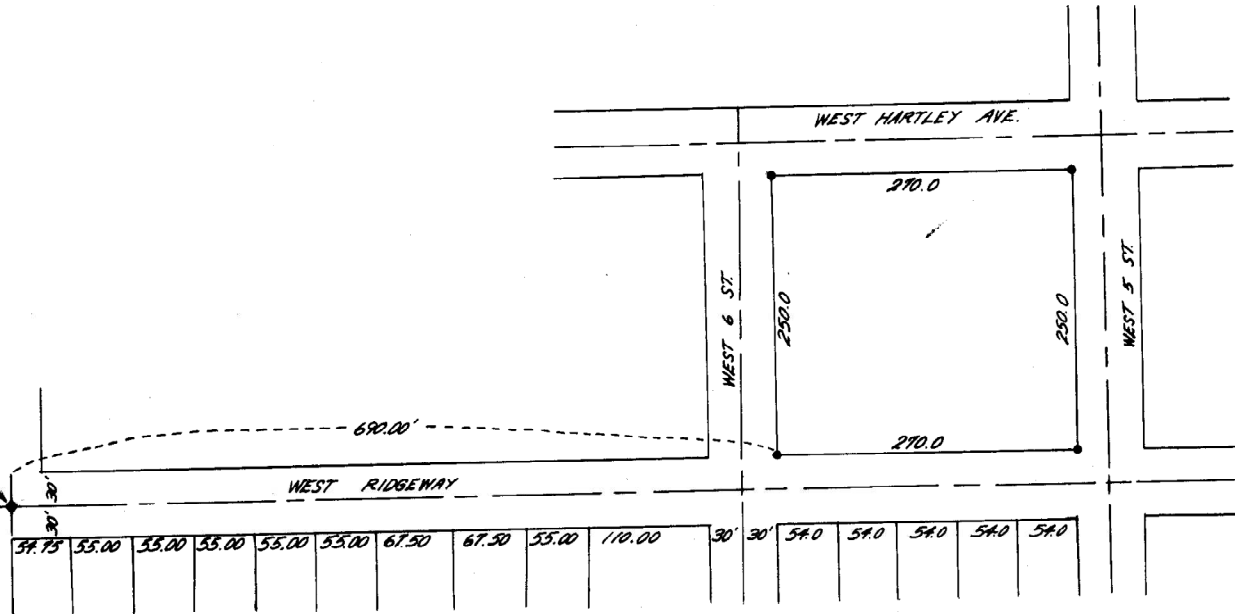

• DENOTES 1/8" I. PIN SET



REGISTERED  
OREGON  
LAND SURVEYOR  
*Wayne O. Harris*  
MAY 6, 1968  
WAYNE O. HARRIS  
346

WAYNE O. HARRIS & ASSOCIATES			
SURVEY FOR CHARLIE KIK			
DESCRIPTIVE PARCEL IN SEC. 10 TOWNSHIP 4 NORTH RANGE 28 EAST W. 4			
HERMISTON, OREGON			
SCALE	DATE	DRN. BY	DRNG. No.
1"=100'	8-20-65	JEB	169-A

B-5-A

B-5