

FOUND: BRASS MONUMENT W. 1/4 COR. SEC. 11

WEST LINE SEC. 11

FIRST ST.

GLADY'S ST.

SECOND ST.

MAIN ST.

SEVENTH ST.

FOUND 3/4 I. PIN

FOUND: 1 1/2" IRON SHAFT SET: 3/4" REBAR ROD

○ DENOTES 1/2" I. PIN SET

REGISTERED OREGON LAND SURVEYOR
Leland H. Ascher
JULY 10, 1964
LELAND H. ASCHER
635









WAYNE O. HARRIS & ASSOCIATES

SURVEY FOR
TIMBER CO.

W. 1/2 LOT 5 BLOCK 8
ORIGINAL TOWN

HERMISTON, OREGON

SCALE	DATE	DRN. BY	DRN. NO.
1" = 50'	3/7/66	L.D.B.	66-173A

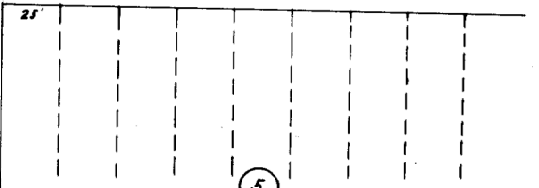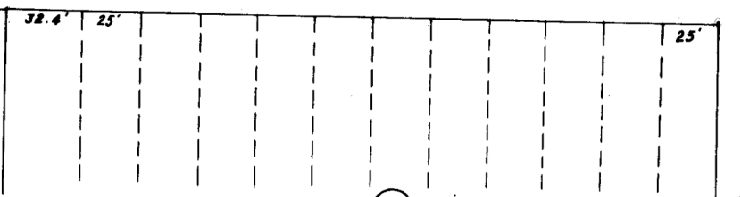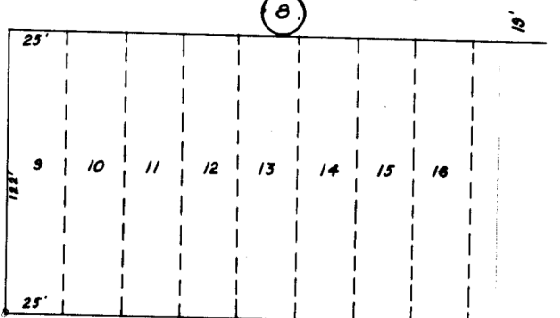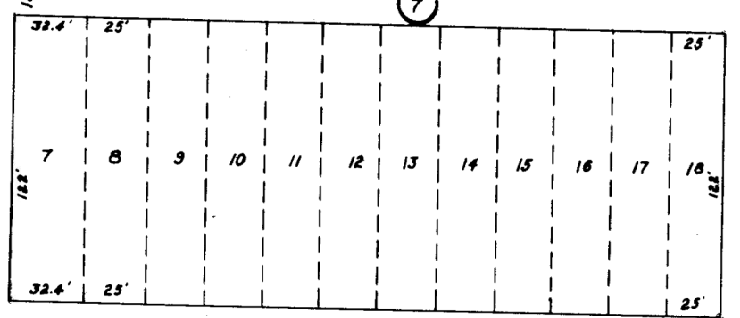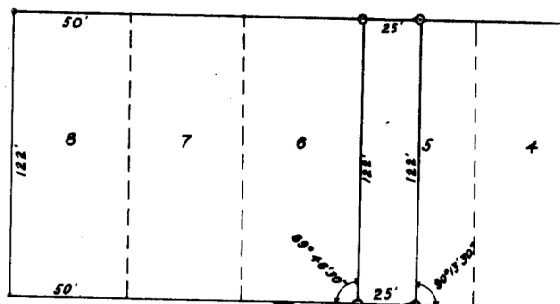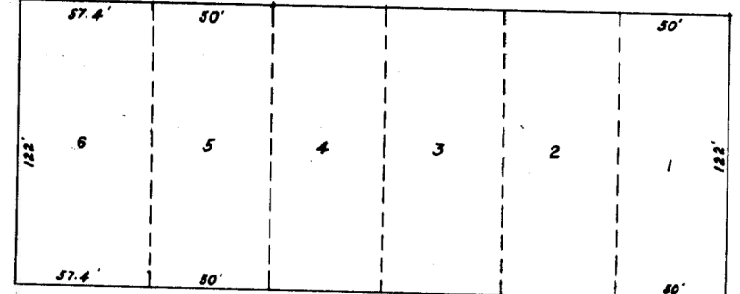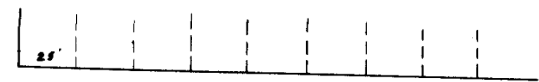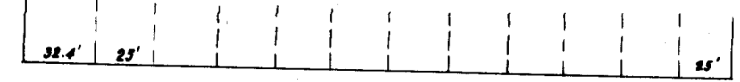

R-9-A