


# CITY OF MILTON - FREEWATER

WILLIAMS ST.



ASSUMED

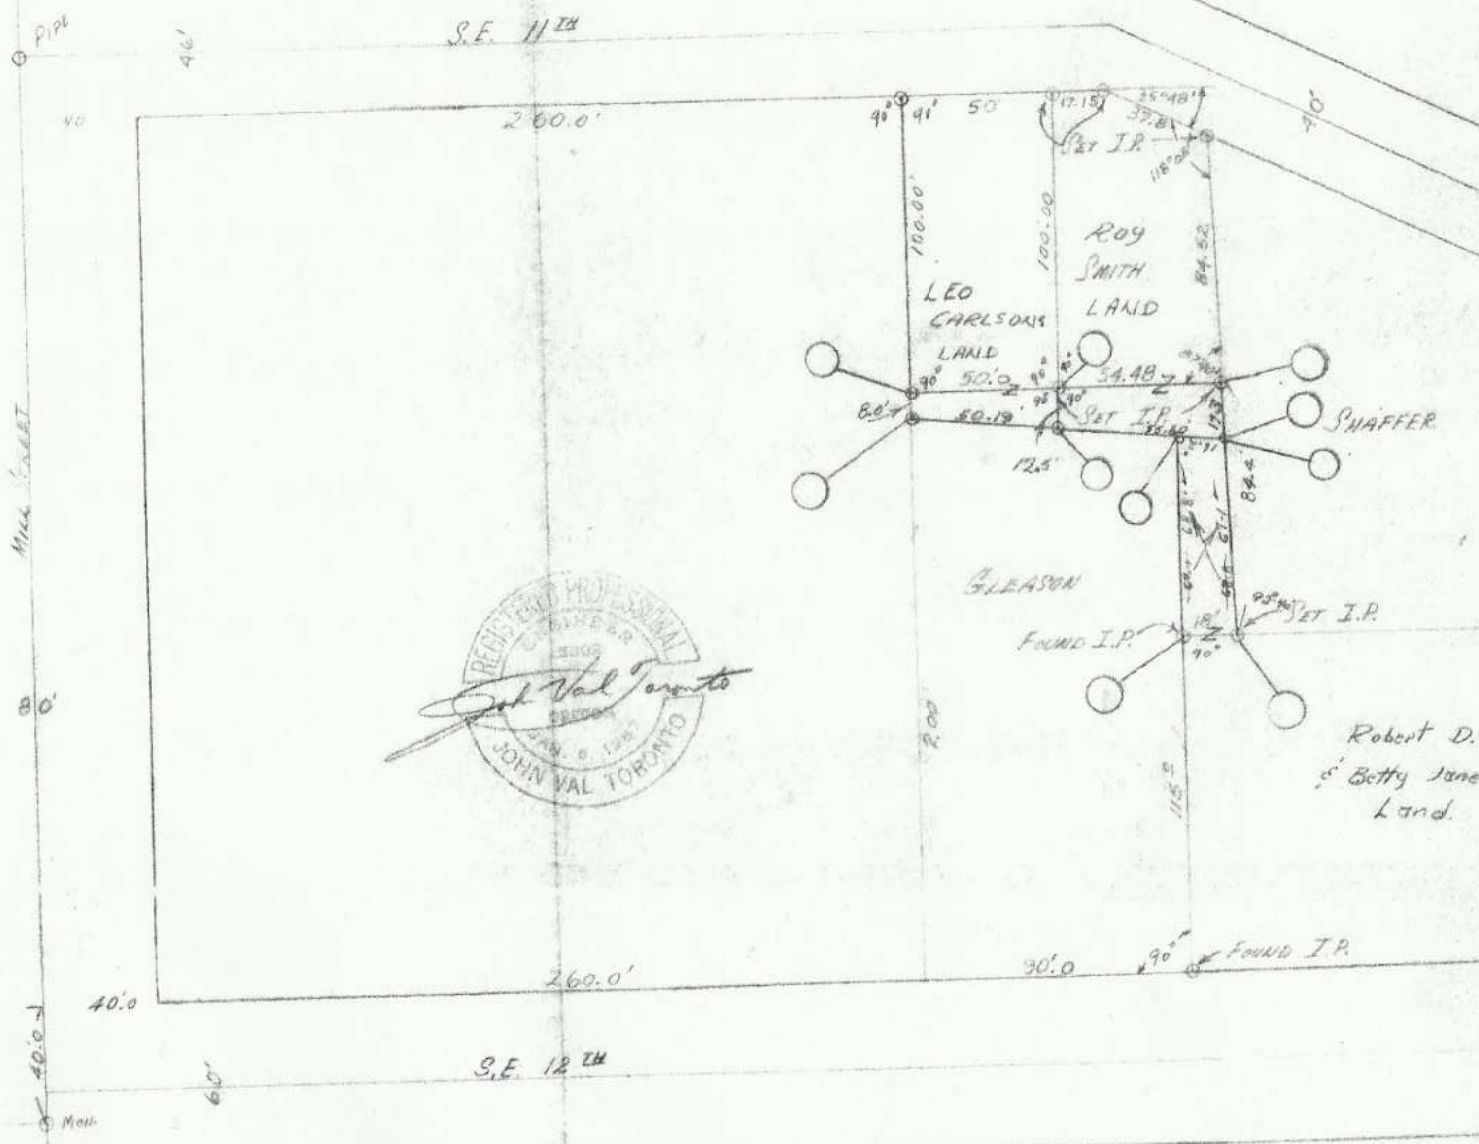

T.5N.R.35  
SW 1/4 NE 1/4 Sec. 12, NOV-1968 F-5-A