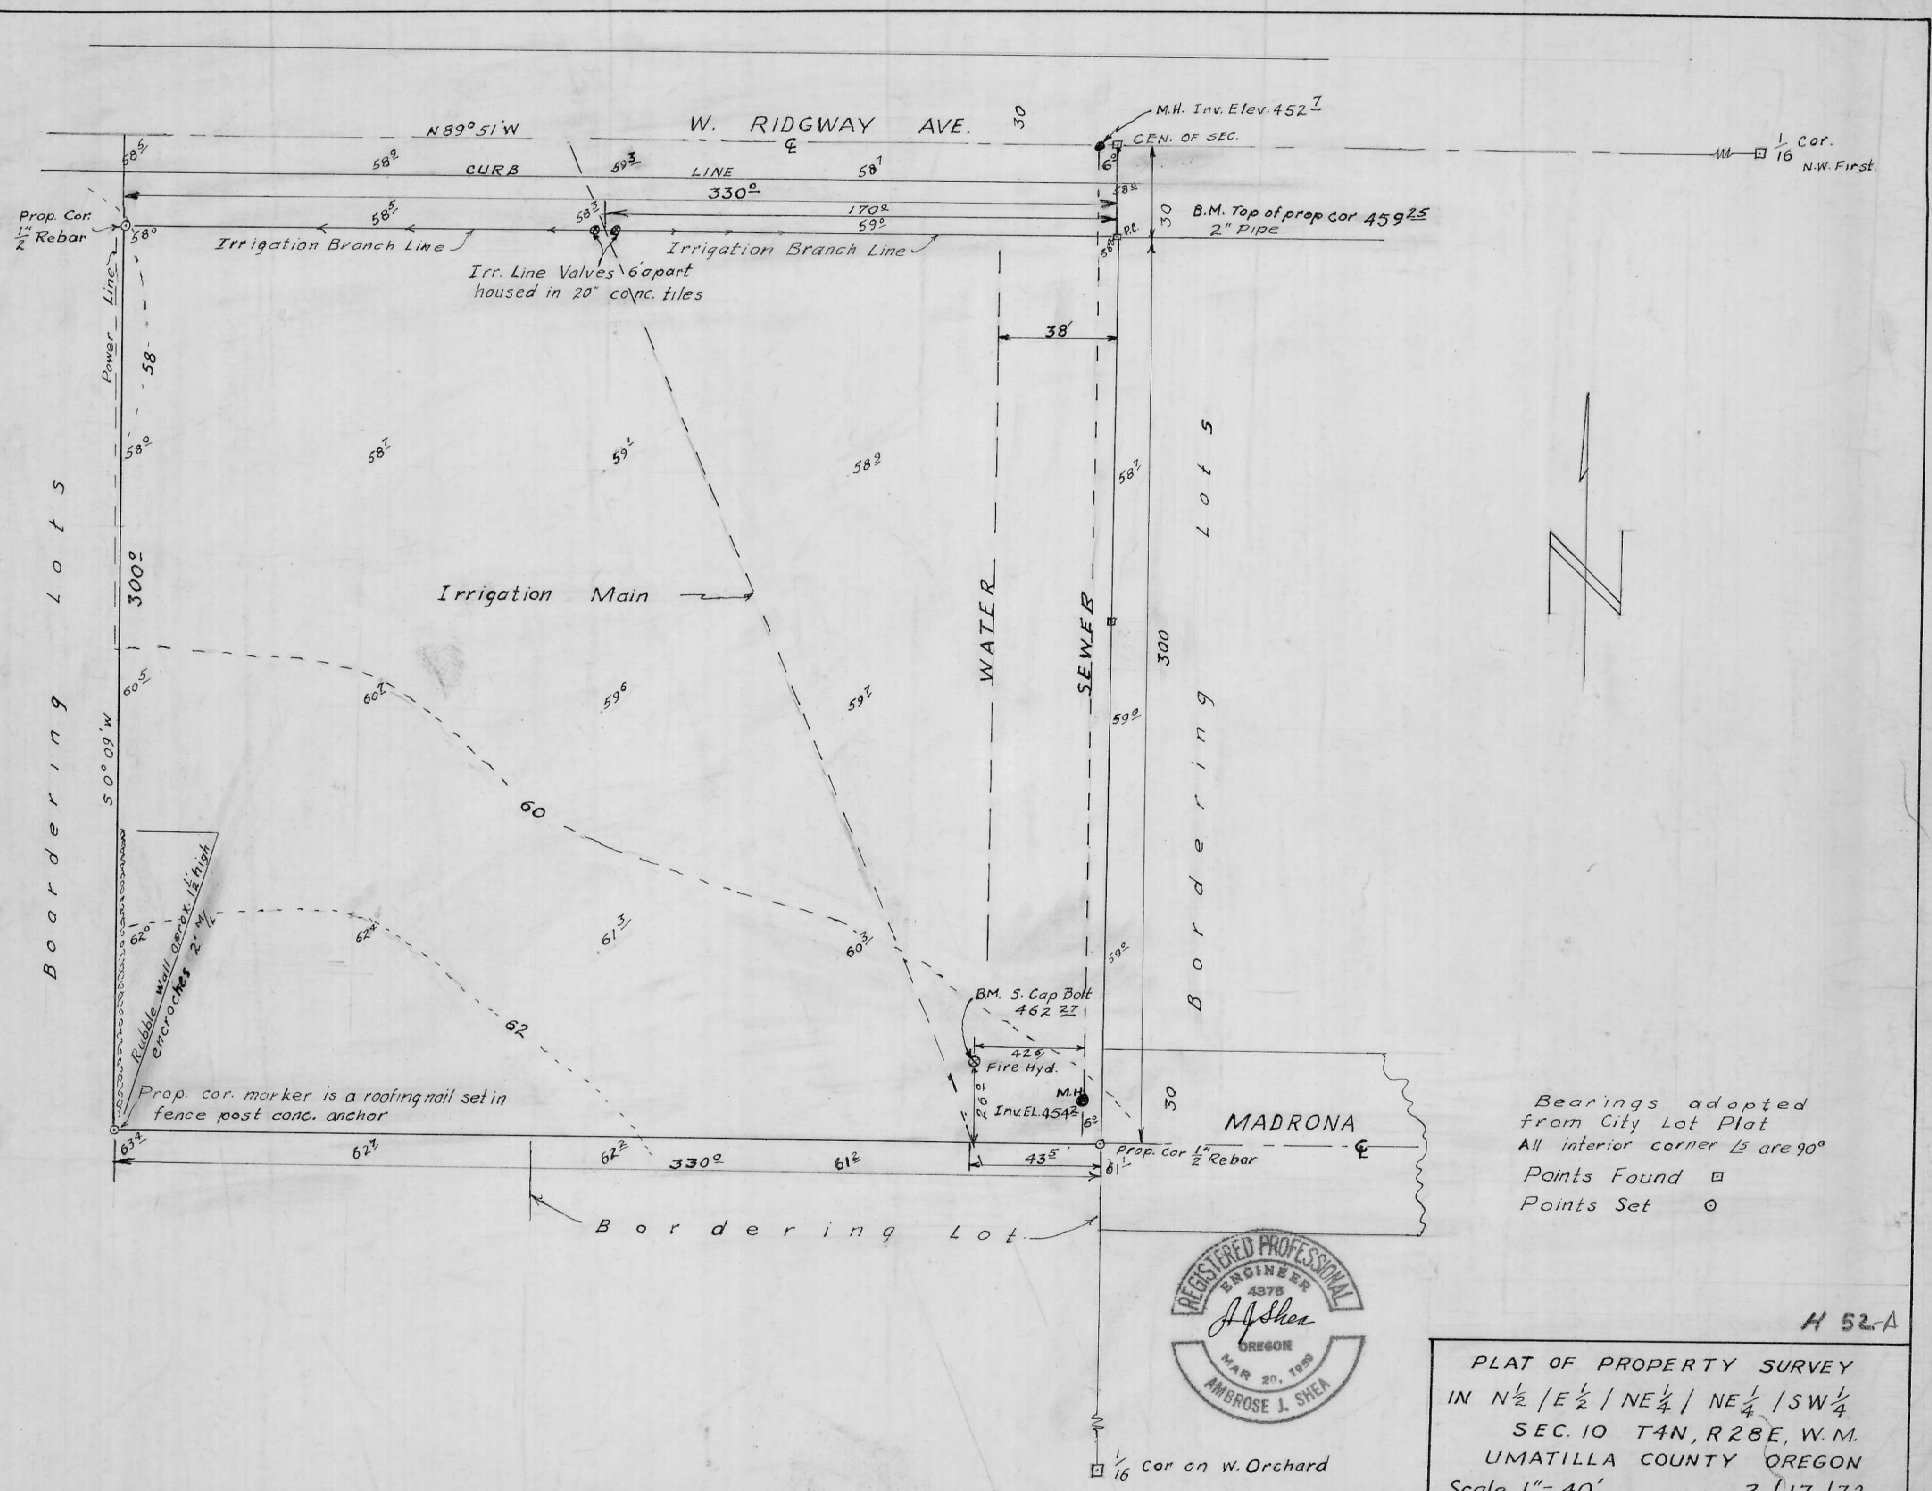

H 52-A

PLAT OF PROPERTY SURVEY
IN N½ / E½ / NE¼ / NE¼ / SW¼
SEC. 10 T4N, R28E, W.M.
UMATILLA COUNTY OREGON
Scale 1" = 40' 2/17/72

H-52-A