


I-8-A


E K L E B E R R Y T R A C T S

BLOCK B
LOT NO. 9

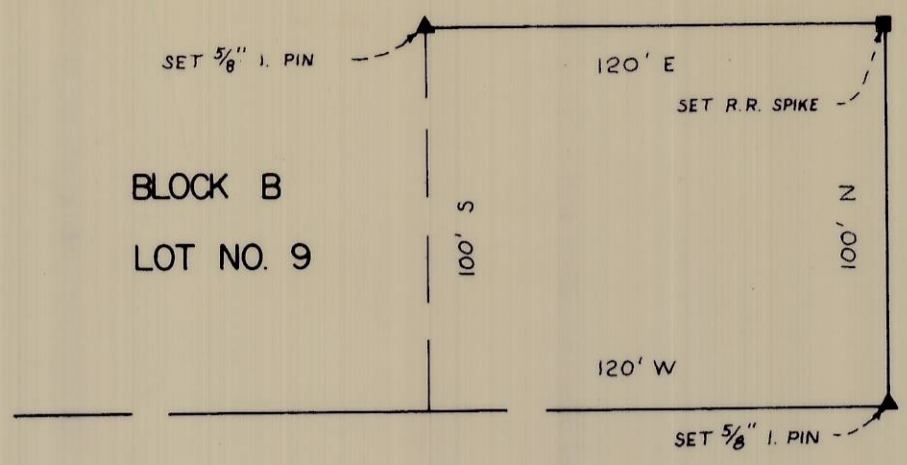

POPLAR AVE.

50'

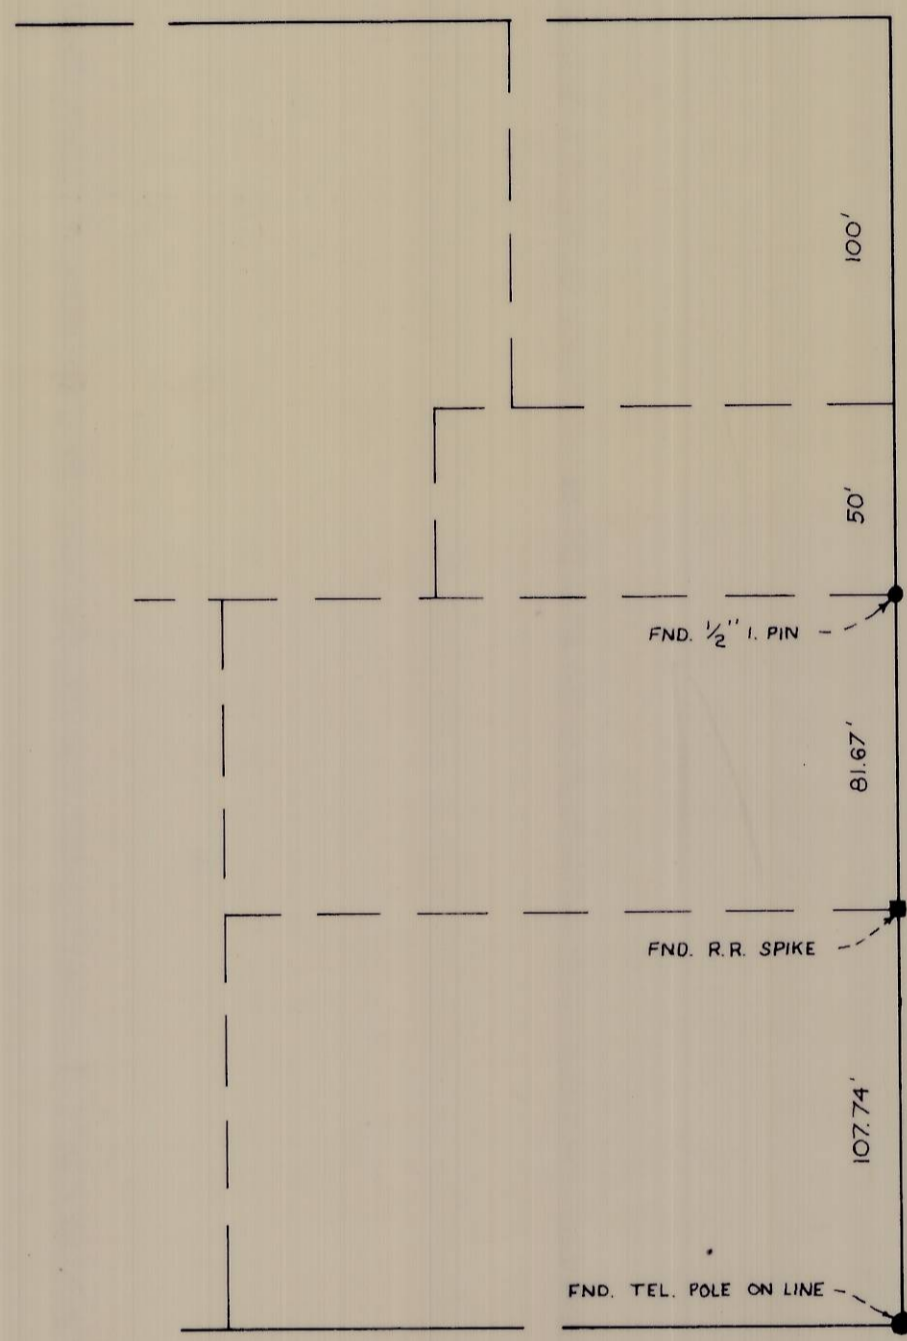

CO. RD. NO. 602

CO. RD. NO. 695 ORCHARD AVE. 50'



WAYNE HARRIS CO. INC.

SURVEY FOR
 GO-MAC MOVING AND STORAGE
 PARCEL IN NE 1/4 SE 1/4
 SEC. 9, T. 4 N., R. 28 E., W. M.

SCALE	DATE	DRN. BY	DRNG. NO.
1" = 50'	11-06-73	JLC	73-260-A

I 8

V-8-I