


I-10-A

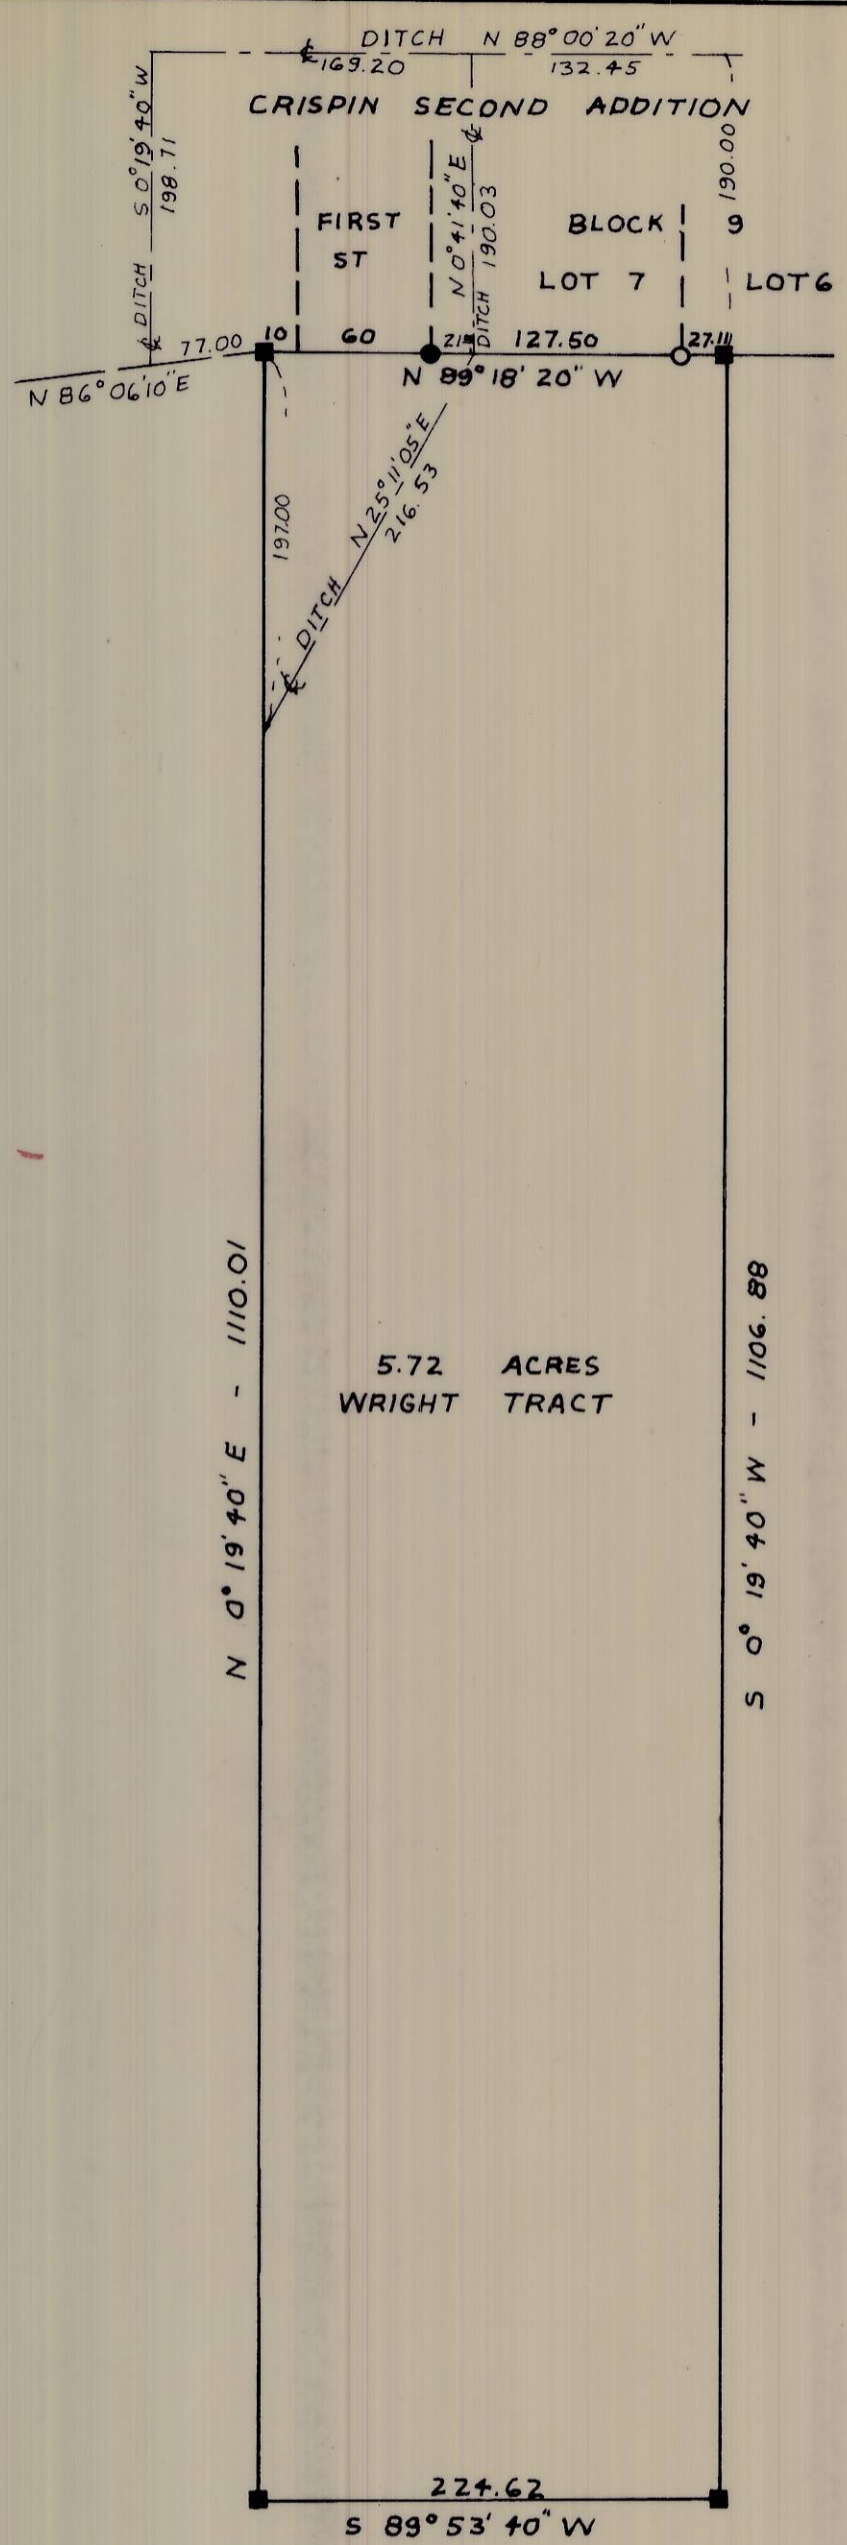


5.72 ACRES
WRIGHT TRACT



BEARINGS ARE BASED UPON
TIES TO N.O.S. STATION "PENDLETON."
THOSE SHOWN ARE TRUE. $\theta = 1^{\circ} 15' 20''$

- FOUND $\frac{1}{2}$ " x 24" I. PIN
- FOUND $\frac{5}{8}$ " x 30" I. PIN
- SET $\frac{3}{4}$ " x 24" I. PIN

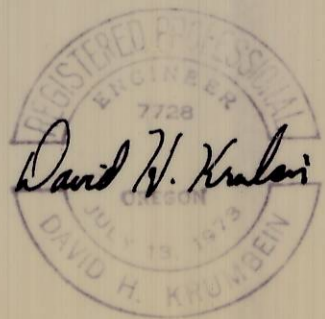

WAYNE HARRIS CO., INC.			
SURVEY FOR CRISPIN RANCHES			
DESCRIPTIVE PARCEL IN			
NW $\frac{1}{4}$ SECTION 7,			
T. 2 N., R. 33 E., W. M.			
SCALE	DATE	DRN BY	DRNG NO
1" = 100'	9-19-73	DHK	73-255-A

I 10

A-10-A