


SEC. 36, T.5N, R.28E.

SCALE: 1" = 800'

NOTE: ALL DISTANCES & BEARINGS SHOWN ARE TRUE.

LEGEND

- ⊕ ————— DENOTES BRASS CAP FND.
- ⊙ ————— DENOTES PIPE FND. (SIZE NOTED)
- ————— DENOTES ROD FND. (SIZE NOTED)
- ————— DENOTES STONE FND.

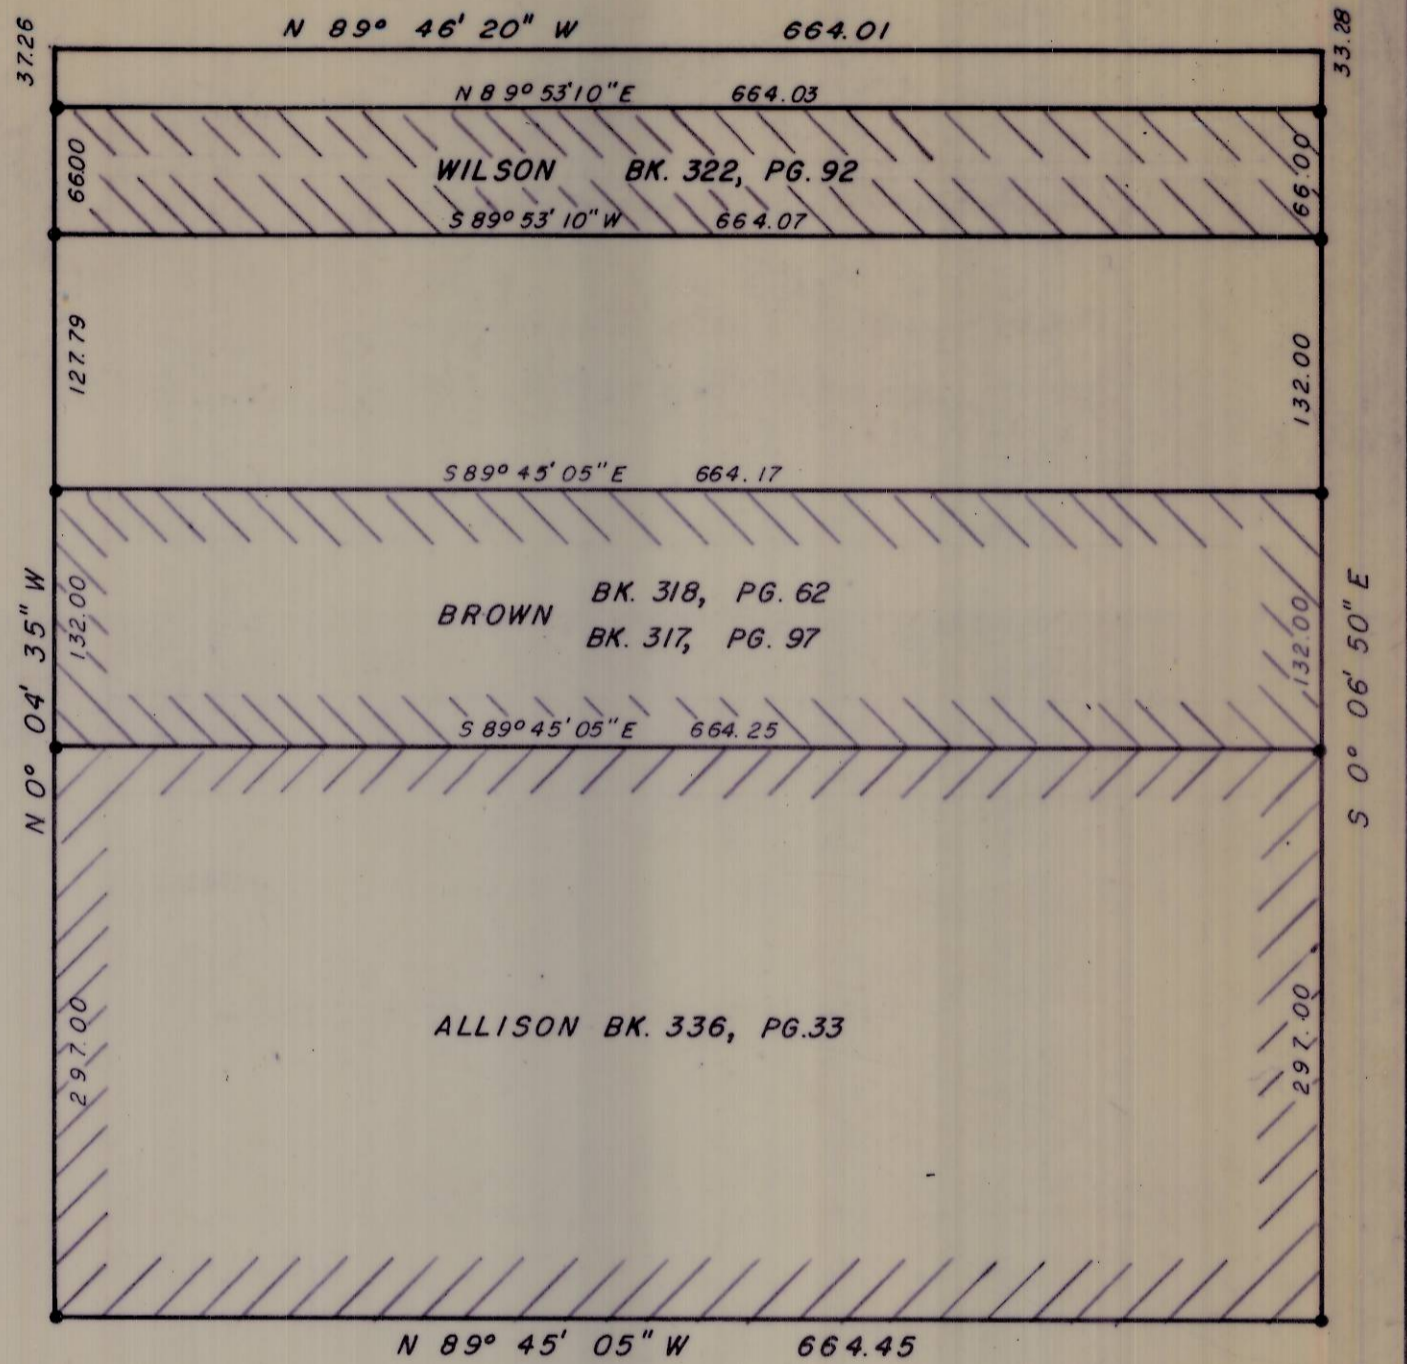

NE 1/4, NE 1/4, SE 1/4 SEC. 36, T.5N, R.28E.

SCALE: 1" = 100'

LEGEND

- ————— DENOTES 1/2" IRON PIN SET

REGISTERED
PROFESSIONAL
LAND SURVEYOR
David H. Kemler
DAVID H. KEMLER
933

SURVEY FOR
ALLISON, WILSON & BROWN
PARCELS IN NE 1/4, NE 1/4, SE 1/4 SEC. 36 T.5N. R. 28E

WAYNE HARRIS CO. INC.
ENGINEERS - SURVEYORS PENDLETON OREGON

SCALE	AS SHOWN	DRN. BY	<i>P.F.S.</i>	DRNG. NO.
DATE	1-16-74	CKD. BY	<i>J.S.C.</i>	75-303A

J-90-A