


J-154-A

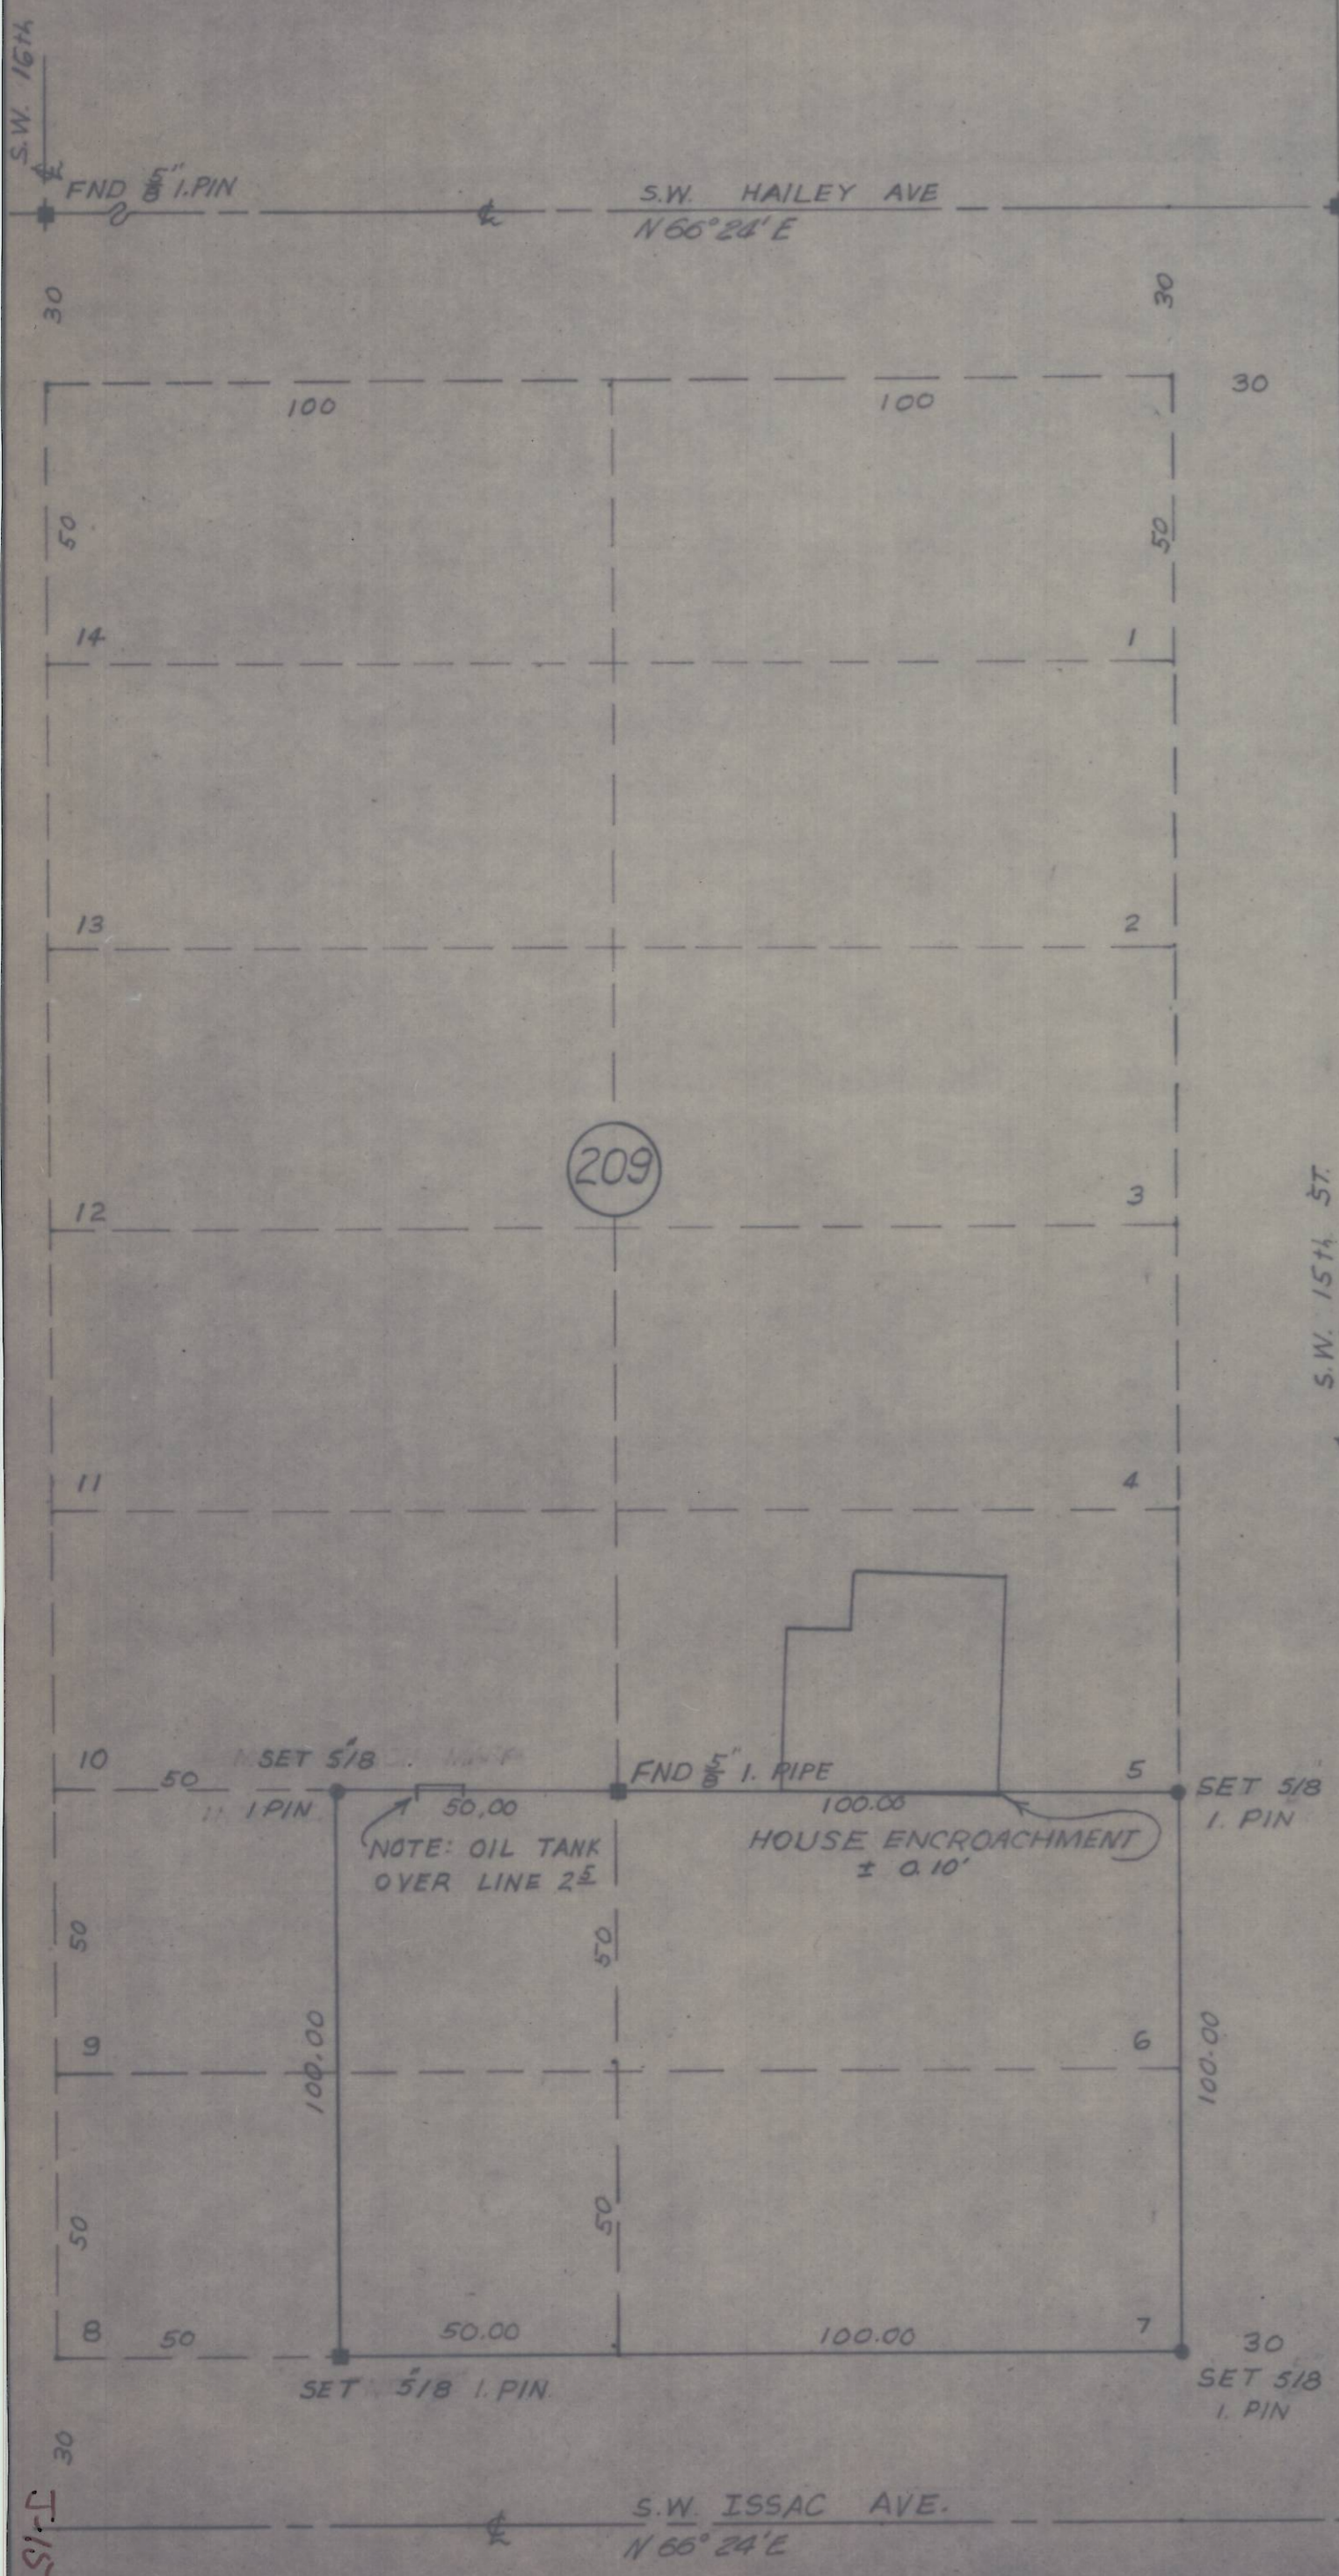

NOTE:
BEARINGS ARE PLAT BEARINGS.

REGISTERED
PROFESSIONAL
LAND SURVEYOR
David H. Krumbein
OREGON
JULY 12, 1970
DAVID H. KRUMBEIN
933

KRUMBEIN ENGINEERING CO ENGINEERS- SURVEYORS- PLANNERS 216 SE 1 ST STR PENDLETON, OREGON	SCALE 1" = 30'
	DATE 11-17-75
Survey for VAN BEEK Lots 6,7, & E 1/2 8,9 Blk. 209 Reservation Addition	DRAWN BY DHK
	CHECKED BY JLC
	DRAWING NO 75-9B

J-154-A

J-154-A