


HERMISTON AVE

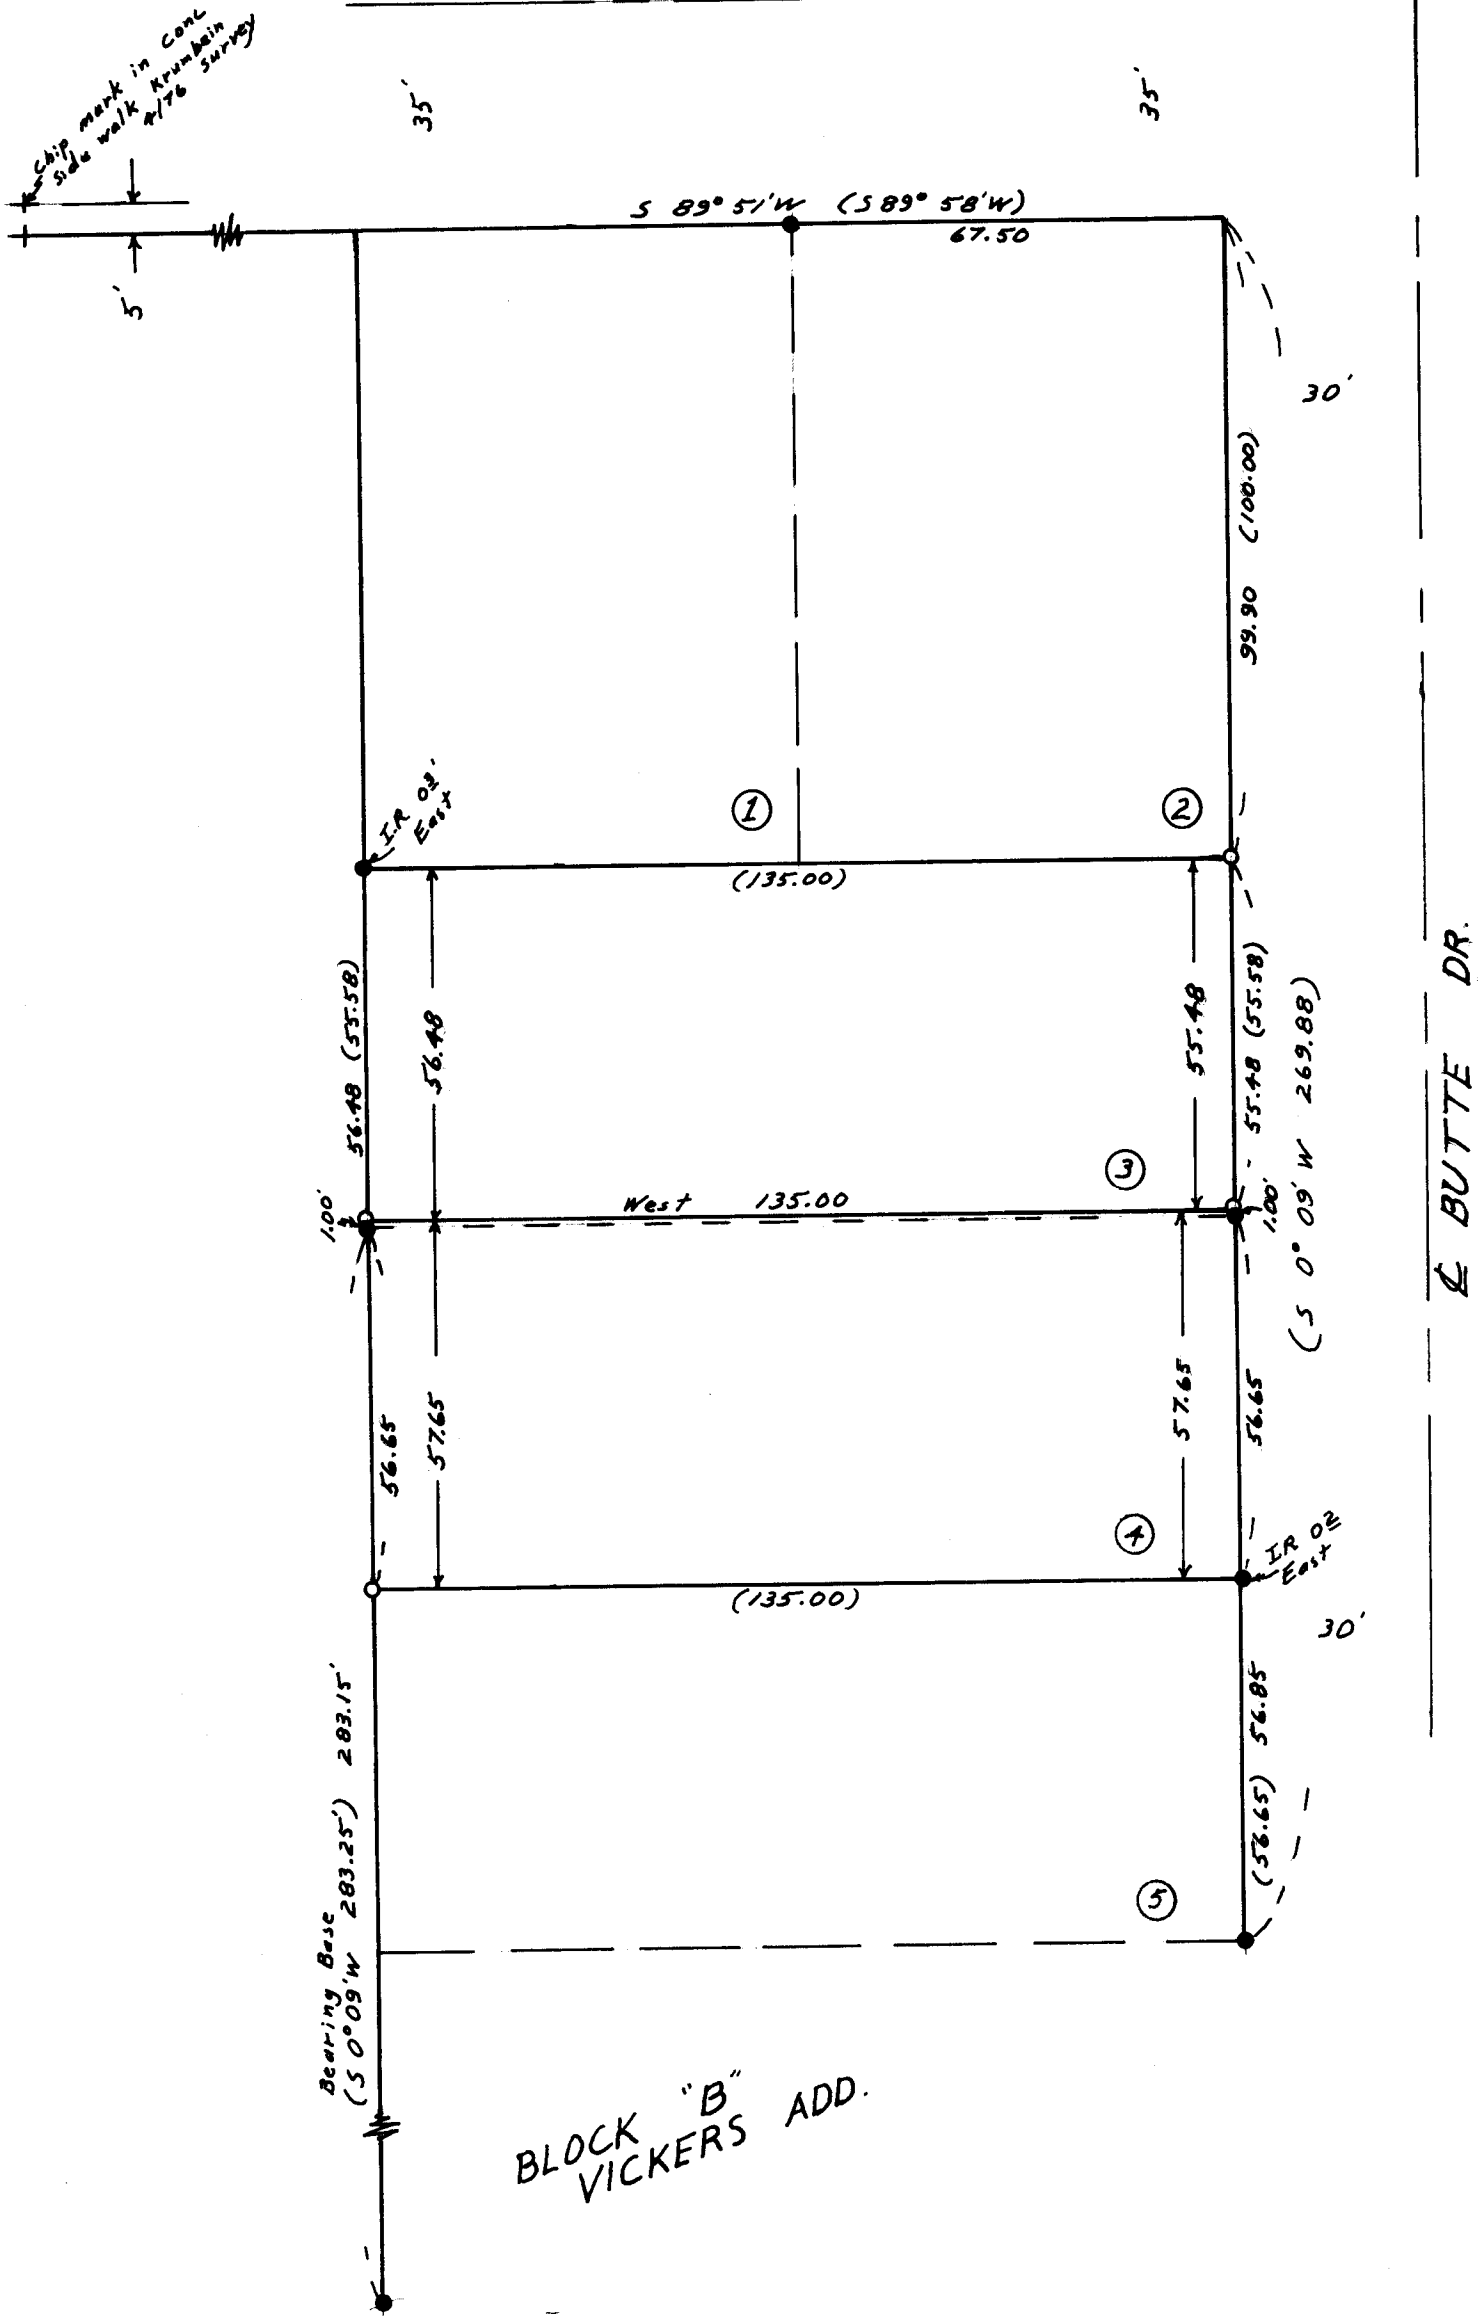

K-094-A

REGISTERED PROFESSIONAL LAND SURVEYOR

D. Dennis Edwards

OREGON JULY 18, 1971

D. DENNIS EDWARDS 951

| | |
|---|---------------------------------|
| SURVEY FOR <i>S. TIMMS & M. THOMAS</i> | |
| LOCATION <i>BLK. "B" VICKERS ADD. to Hermiston.</i> | |
| S.W. 4 SEC. 10, T 4 N, R 28 E, W.M., UMATILLA COUNTY, OREGON | |
| DATE 4/19/76 | SCALE: 1" = 30' |
| ● MONUMENTS FOUND (1/2" IRs) | (000) OF RECORD |
| ○ 1/2" IRON RODS SET | JOB NO. 57604072 |
| EDWARDS SURVEYING 567-3336 | P. O. Box 763 Hermiston, Ore |