


N-41-A

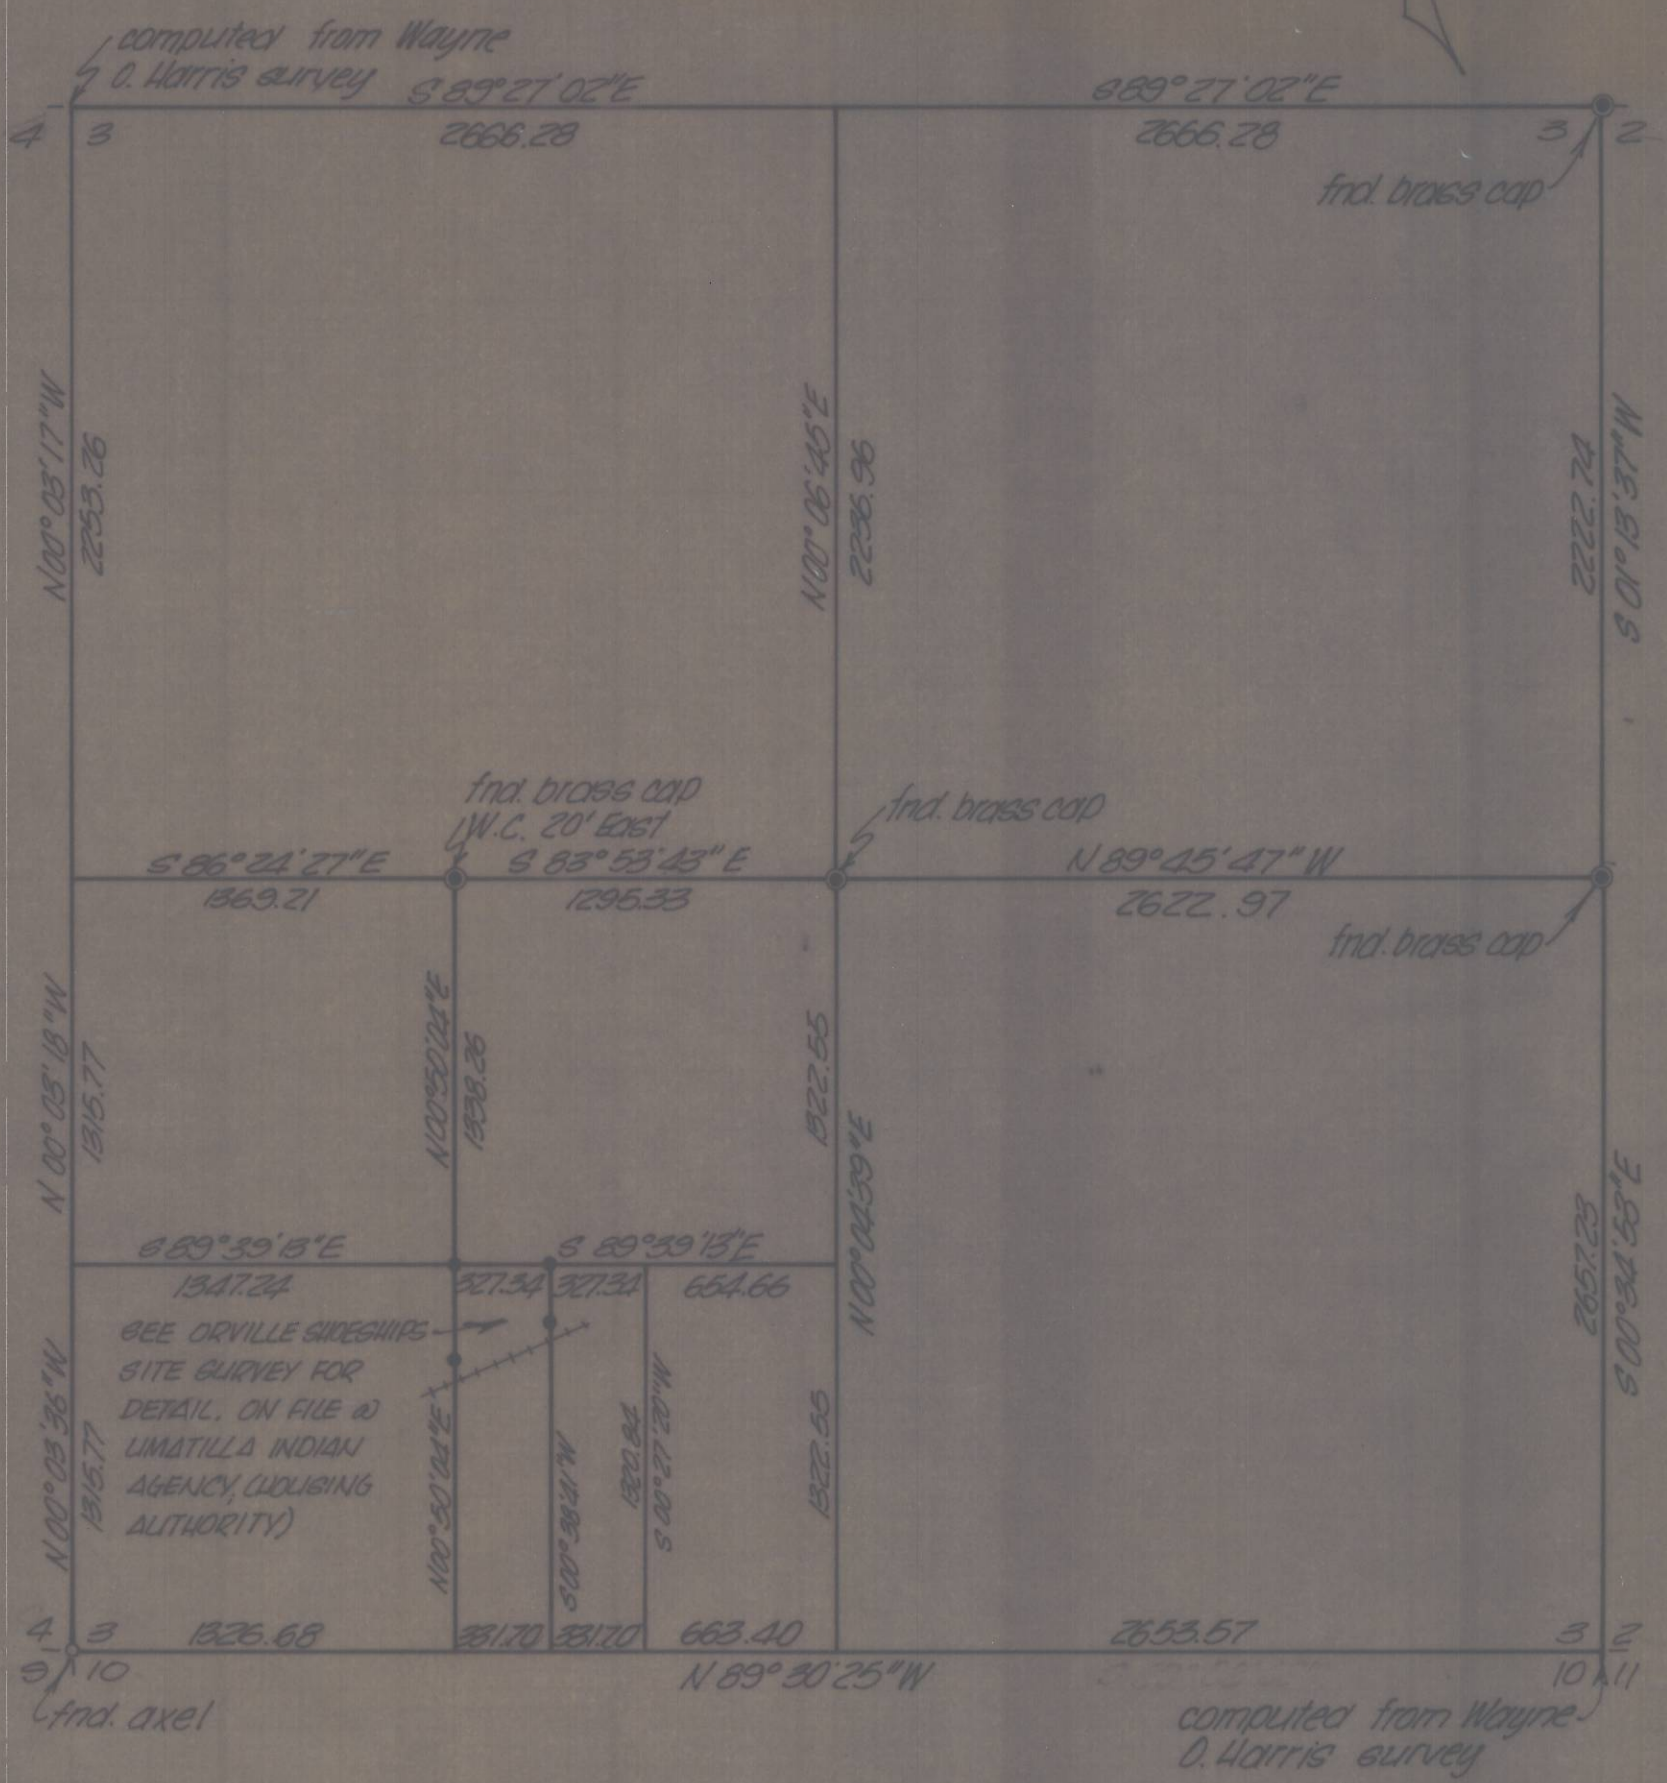

• - denotes 5/8 in. pin set

REGISTERED
PROFESSIONAL
LAND SURVEYOR

David H. Krumbein

OREGON
JULY 17, 1970
DAVID H. KRUMBEIN
933

K KRUMBEIN ENGINEERING CO ENGINEERS - SURVEYORS - PLANNERS 221 S. Main, Pendleton, Oregon	SCALE N.T.S.
	DATE April 18, 1977
Revised survey for UMATILLA TRIBAL OFFICE Section 3, T2N, R34E	DRN BY R.L.P.
	CKD BY J.L.C.
	DRNG NO 77-08

N-41-A

N-41-A