


O-61-A

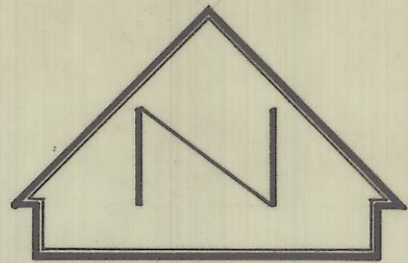

SCALE 1" = 20' - 0"

• 3/8" IRON RODS SET BEARINGS BASED ON RESERVATION ADDITION PLAT

REGISTERED PROFESSIONAL LAND SURVEYOR  
William R. Wells  
OREGON  
JULY 22, 1977  
WILLIAM R. WELLS  
1106

FOUND RAILROAD SPIKE AT STREET & INTERSECTION SET AS PART OF CITY L.I.D. CONTRACT

FOUND RAILROAD SPIKE AT STREET & INTERSECTION SET AS PART OF CITY L.I.D. CONTRACT

S. E. ISAAC STREET  
STREET S 66° 24' W 260.00'

S. E. 8<sup>TH</sup> ST.  
S. E. 7<sup>TH</sup> ST.

PROPERTY OF RICHARD & PATRICIA TYLER

PROPERTY OF CHARLES A. & SALLY M. ARVIDSON  
LOT 16 PLUS THE NORTHERLY 5.00 FEET OF LOT 15 BLOCK 258 RESERVATION ADDITION PENDLETON, OREGON  
ORIGINAL PROPERTY LINE  
S 66° 24' W 100.00'  
N 66° 24' E 100.00'

PROPERTY OF KAY L. SATTERWHITE

PROPERTY OF CHARLES E. & JANICE C. WILLIAMS

WALLULIS PROJECT NO:	77-128
AGENCY PROJECT NO:	
PROJECT:	
PROPERTY SURVEY FOR CHARLES A. & SALLY M. ARVIDSON	
WALLULIS & ASSOCIATES, INC.	
ENGINEERING & PLANNING	
5 S. E. NINE AVENUE	108 EAST MAIN
PENDLETON, OREGON 97801	HERMISTON, OREGON 97838
503-276-1598	503-567-3331
SCALE: 1" = 20' - 0"	DATE: DEC. 30, 1977
DES BY:	DR BY: CA
CK BY:	
TITLE:	REVISIONS
DRAWING:	
SHEET	OF

O-61-A