


T2N-R31E 12 7
13 18 T2N-R32E

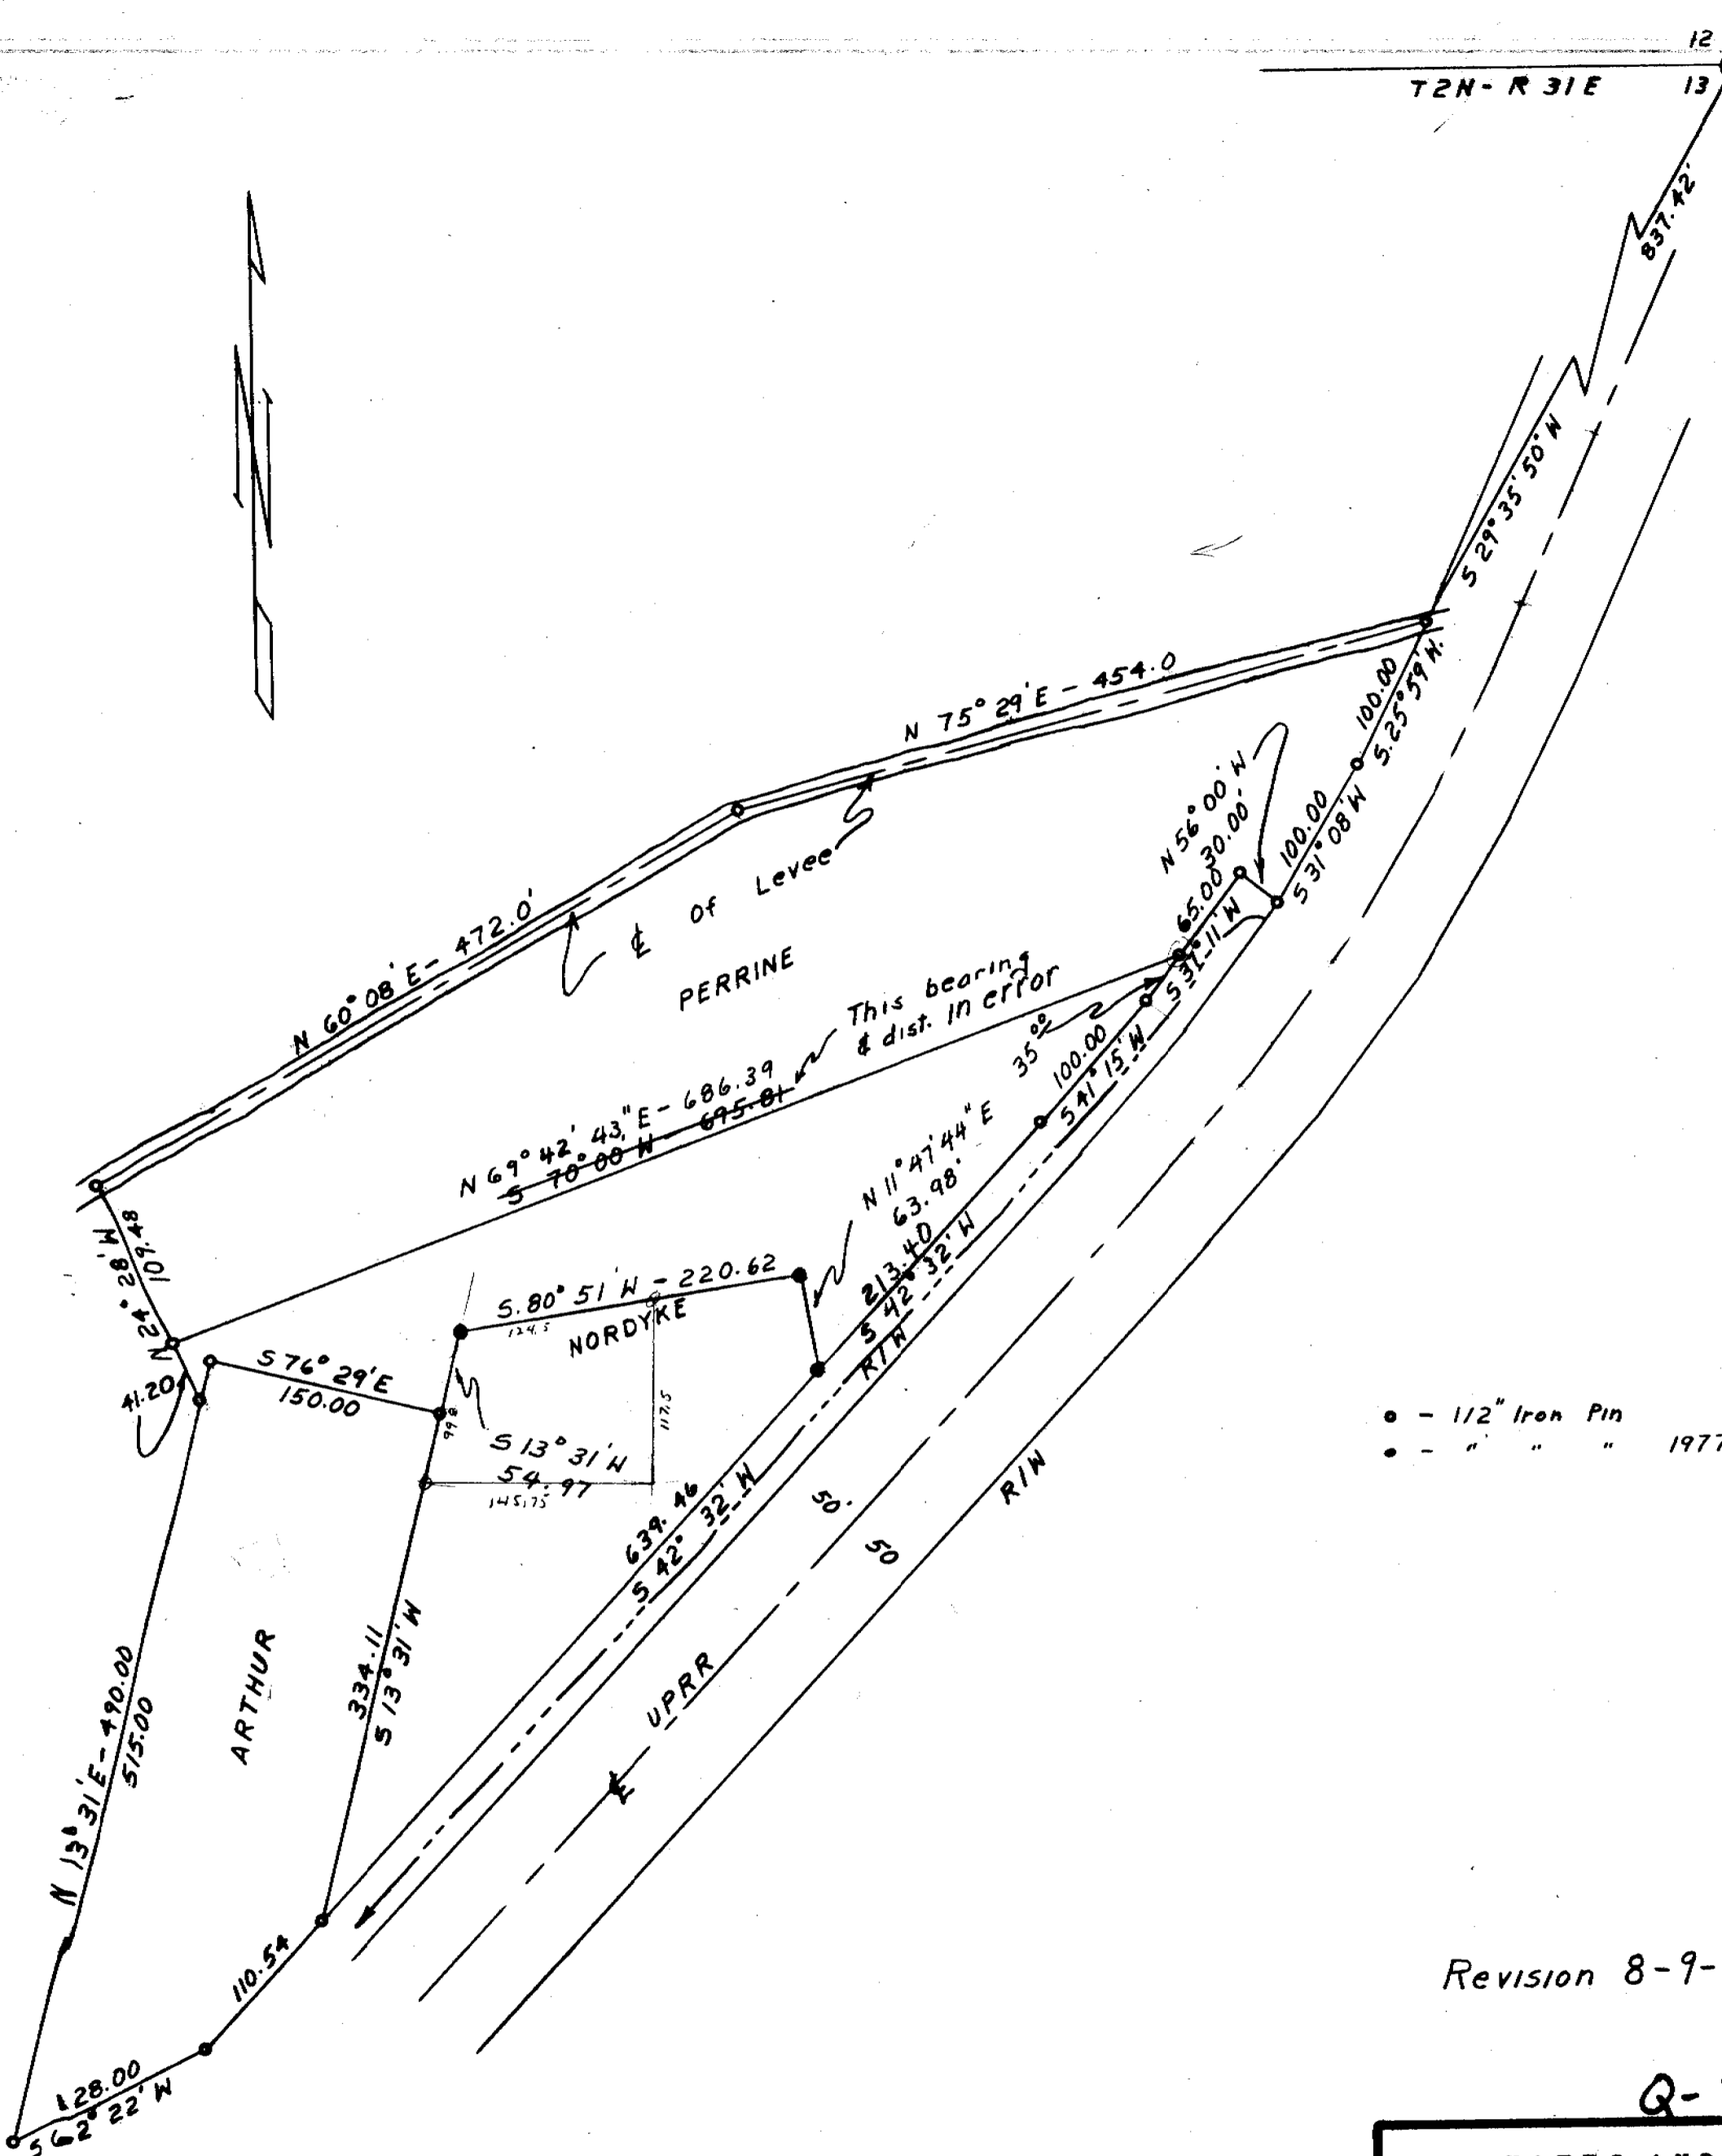

• - 1/2" Iron Pin
• - " " " 1977

Revision 8-9-77

Q-79-A

REGISTERED
OREGON
LAND SURVEYOR
Wayne O. Harris
MAY 6, 1955
WAYNE O. HARRIS
346

HAYES AND HARRIS				
Survey For				
E. W. PERRINE				
Parcel In Section 13				
T. 2 N.-R. 31 E., W.M.				
Scale	Date	Drn.	By	Drng. NO.
1"=100'	3/15/61	WOH		61-181C

Q-79-A