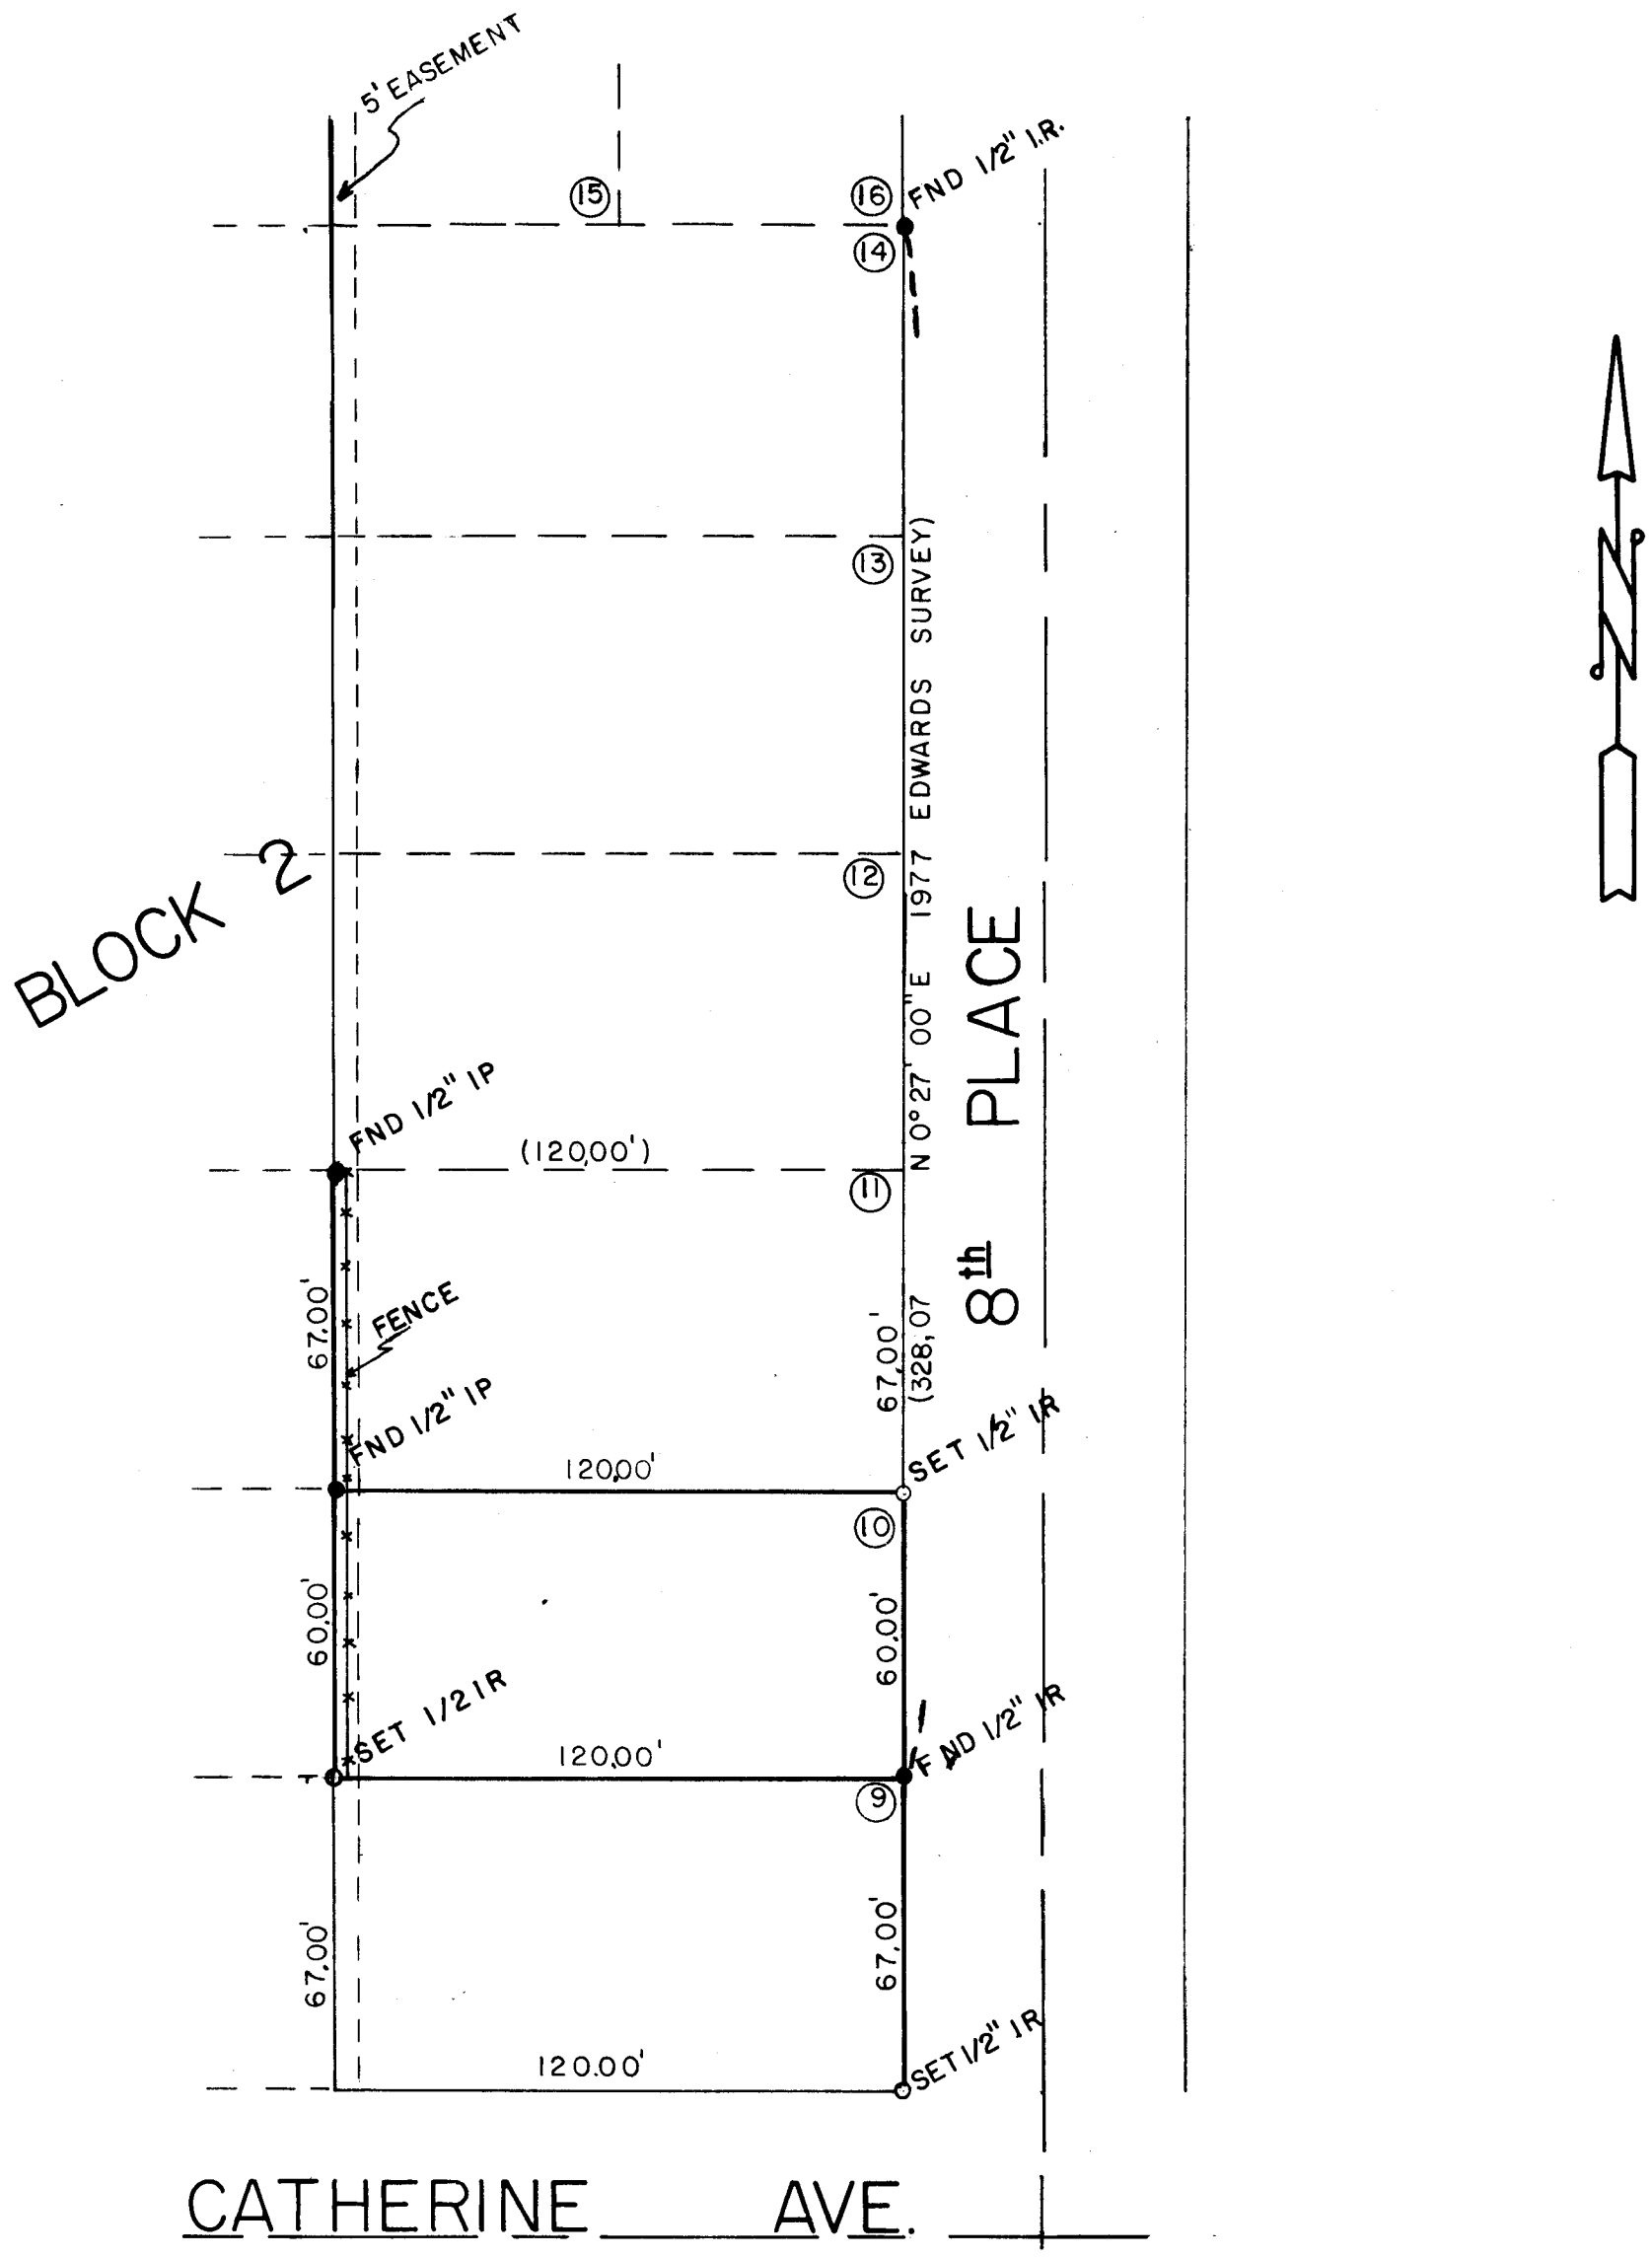

SURVEY FOR C. NEWMAN

Q-0117-A

LOCATION BLOCK 2 BAKER ADD. NE 1/4
CITY of HERMISTON
SEC. 11, T 4 N, R 28 E, W.M., UMATILLA COUNTY, OREGON

DATE 12-18-78 SCALE 1" = 40'

● MONUMENTS FOUND ~~(000) OF RECORD~~

o IRON RODS SET JOB NO. S7812462

EDWARDS SURVEYING
567-3336

P. O. Box 763
Hermiston, Ore.

REGISTERED PROFESSIONAL LAND SURVEYOR
G. Dennis Edwards
OREGON JULY 16, 1971
G. DENNIS EDWARDS
951