



Q-259-A  
OR19

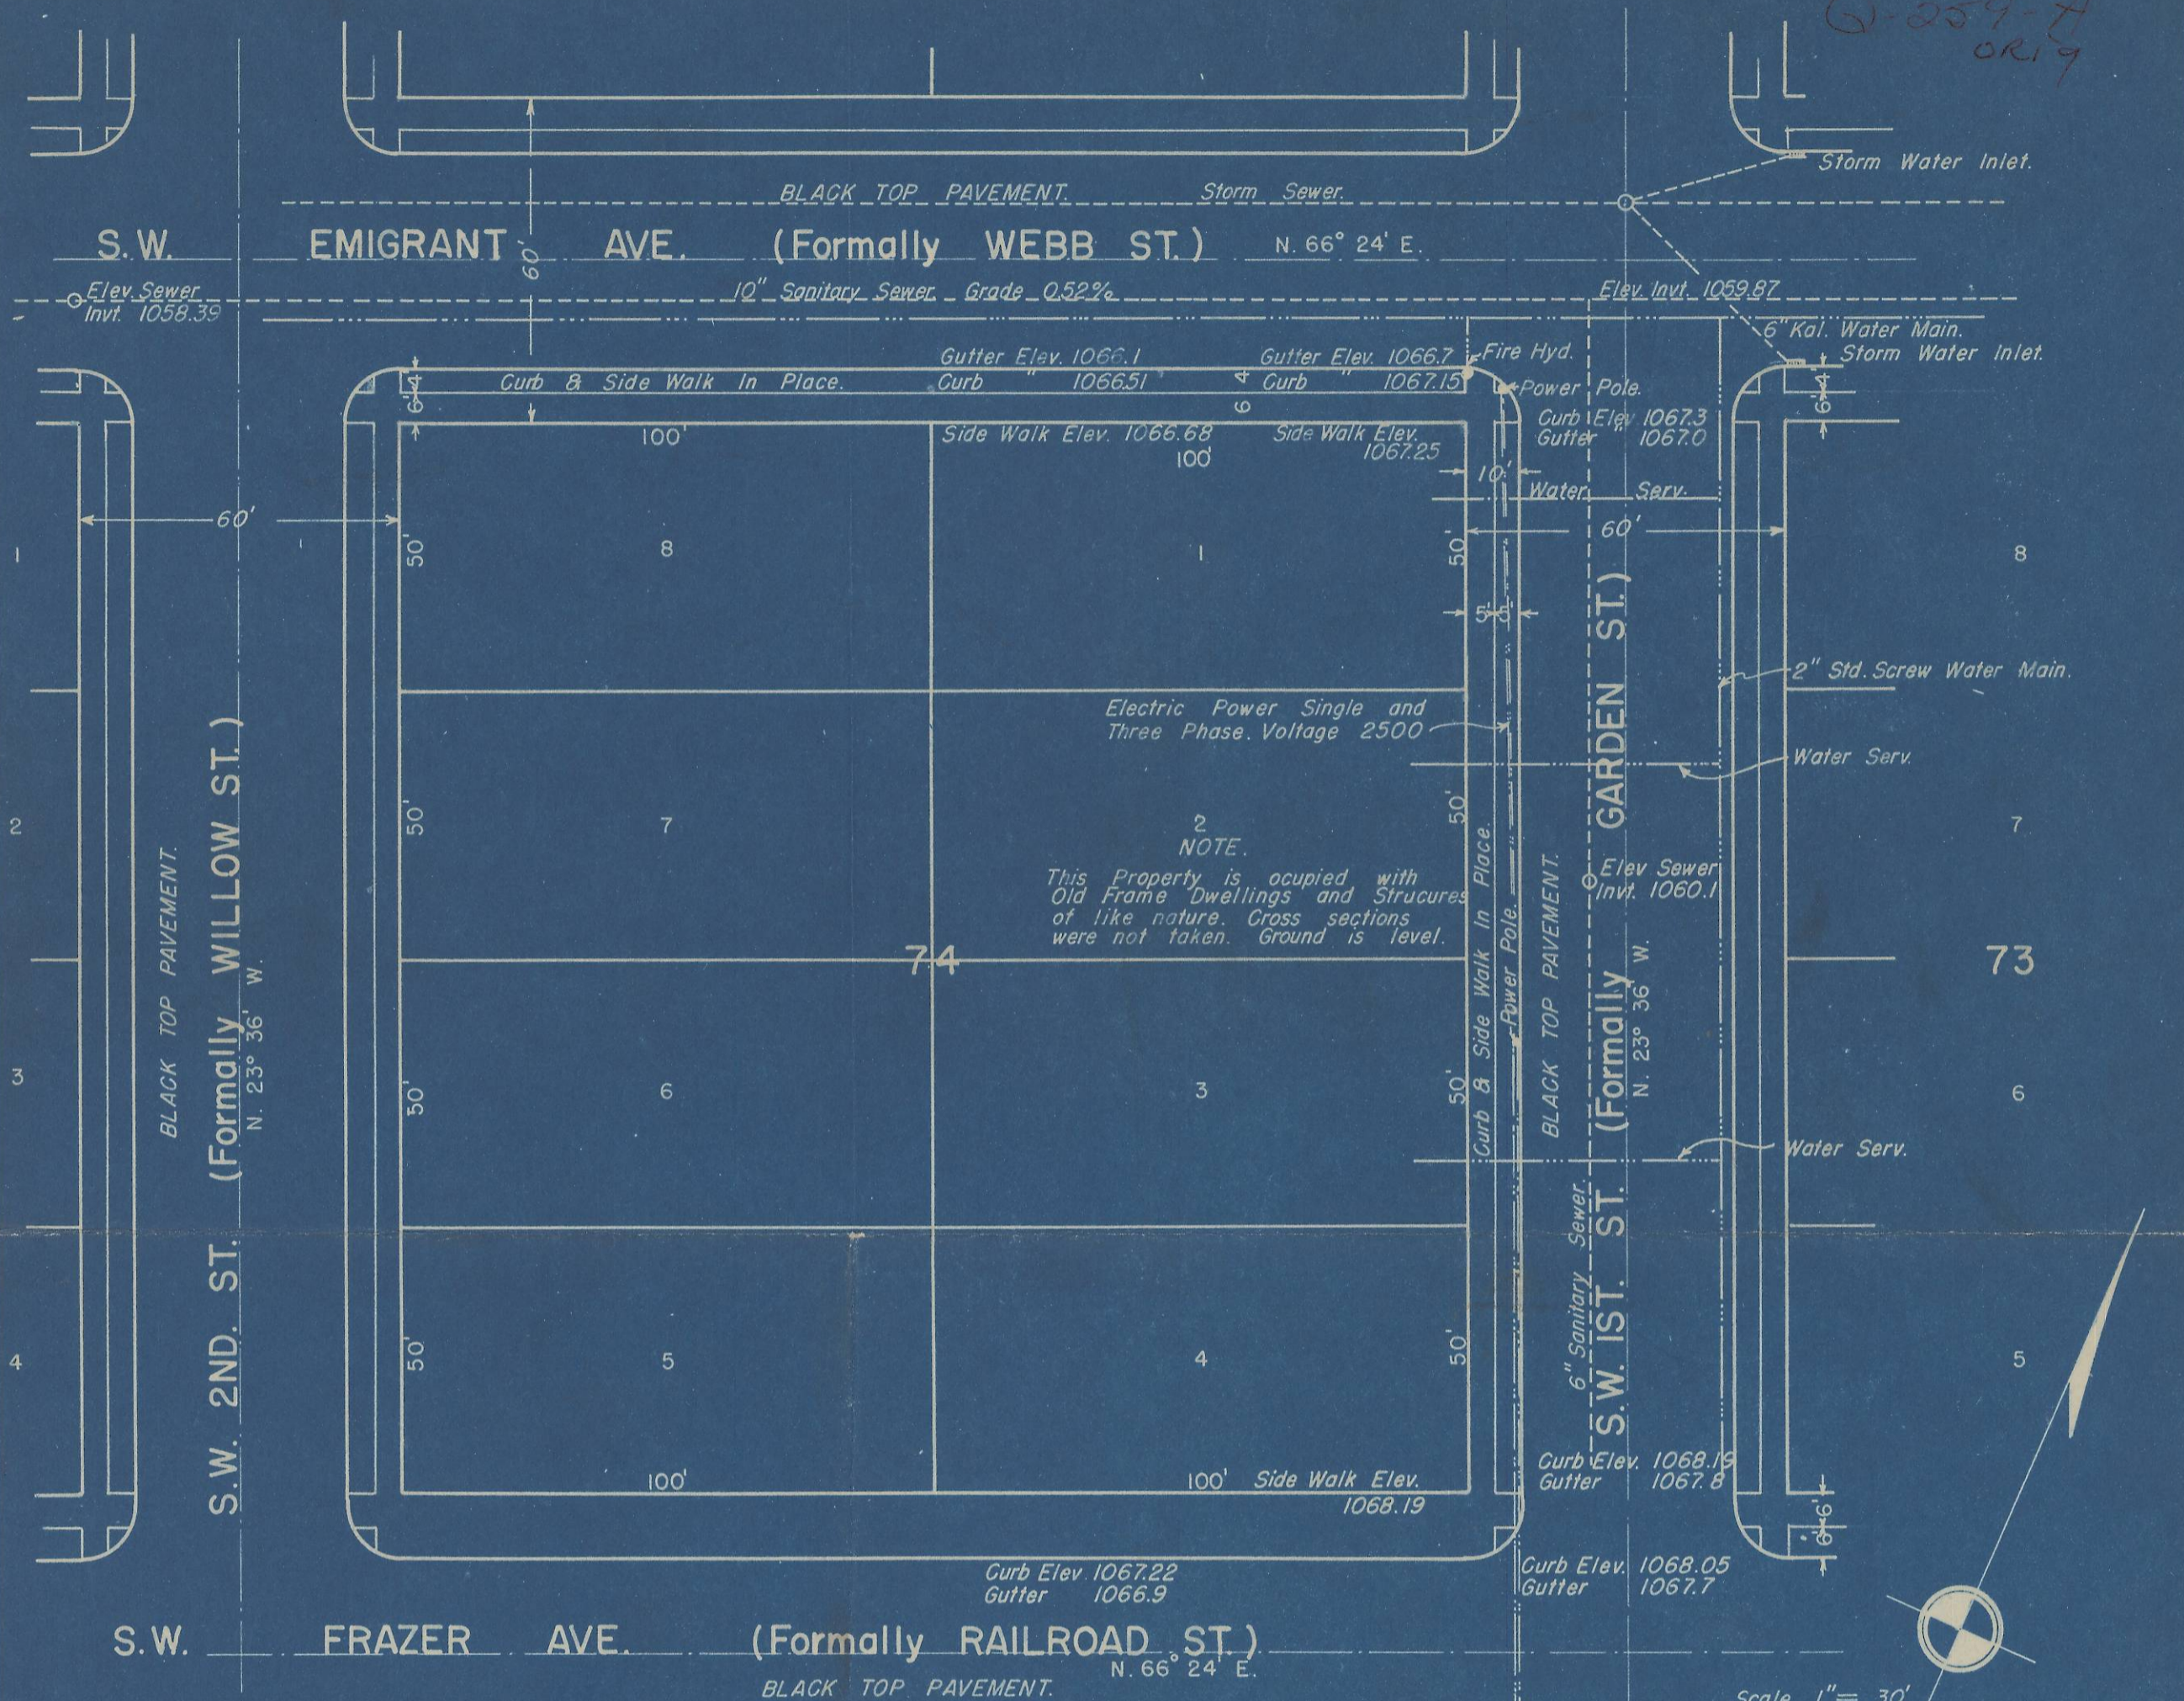

MAP OF BLOCK 74  
 RESERVATION ADDITION TO PENDLETON, OREGON.  
 SURVEYED FOR SAFEWAY STORES PORTLAND, ORE.

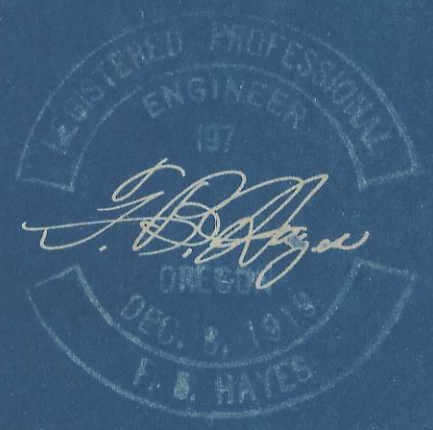

255  
 Q-259-A