
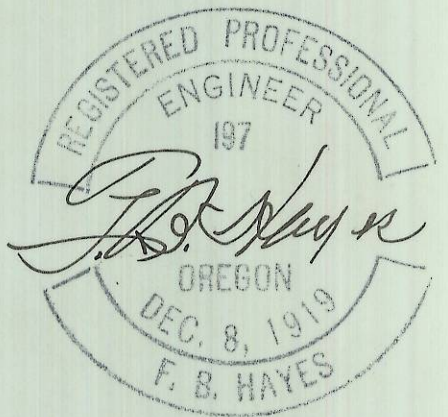
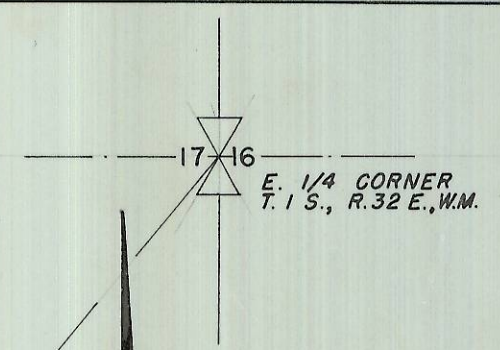


Everett Montgomery

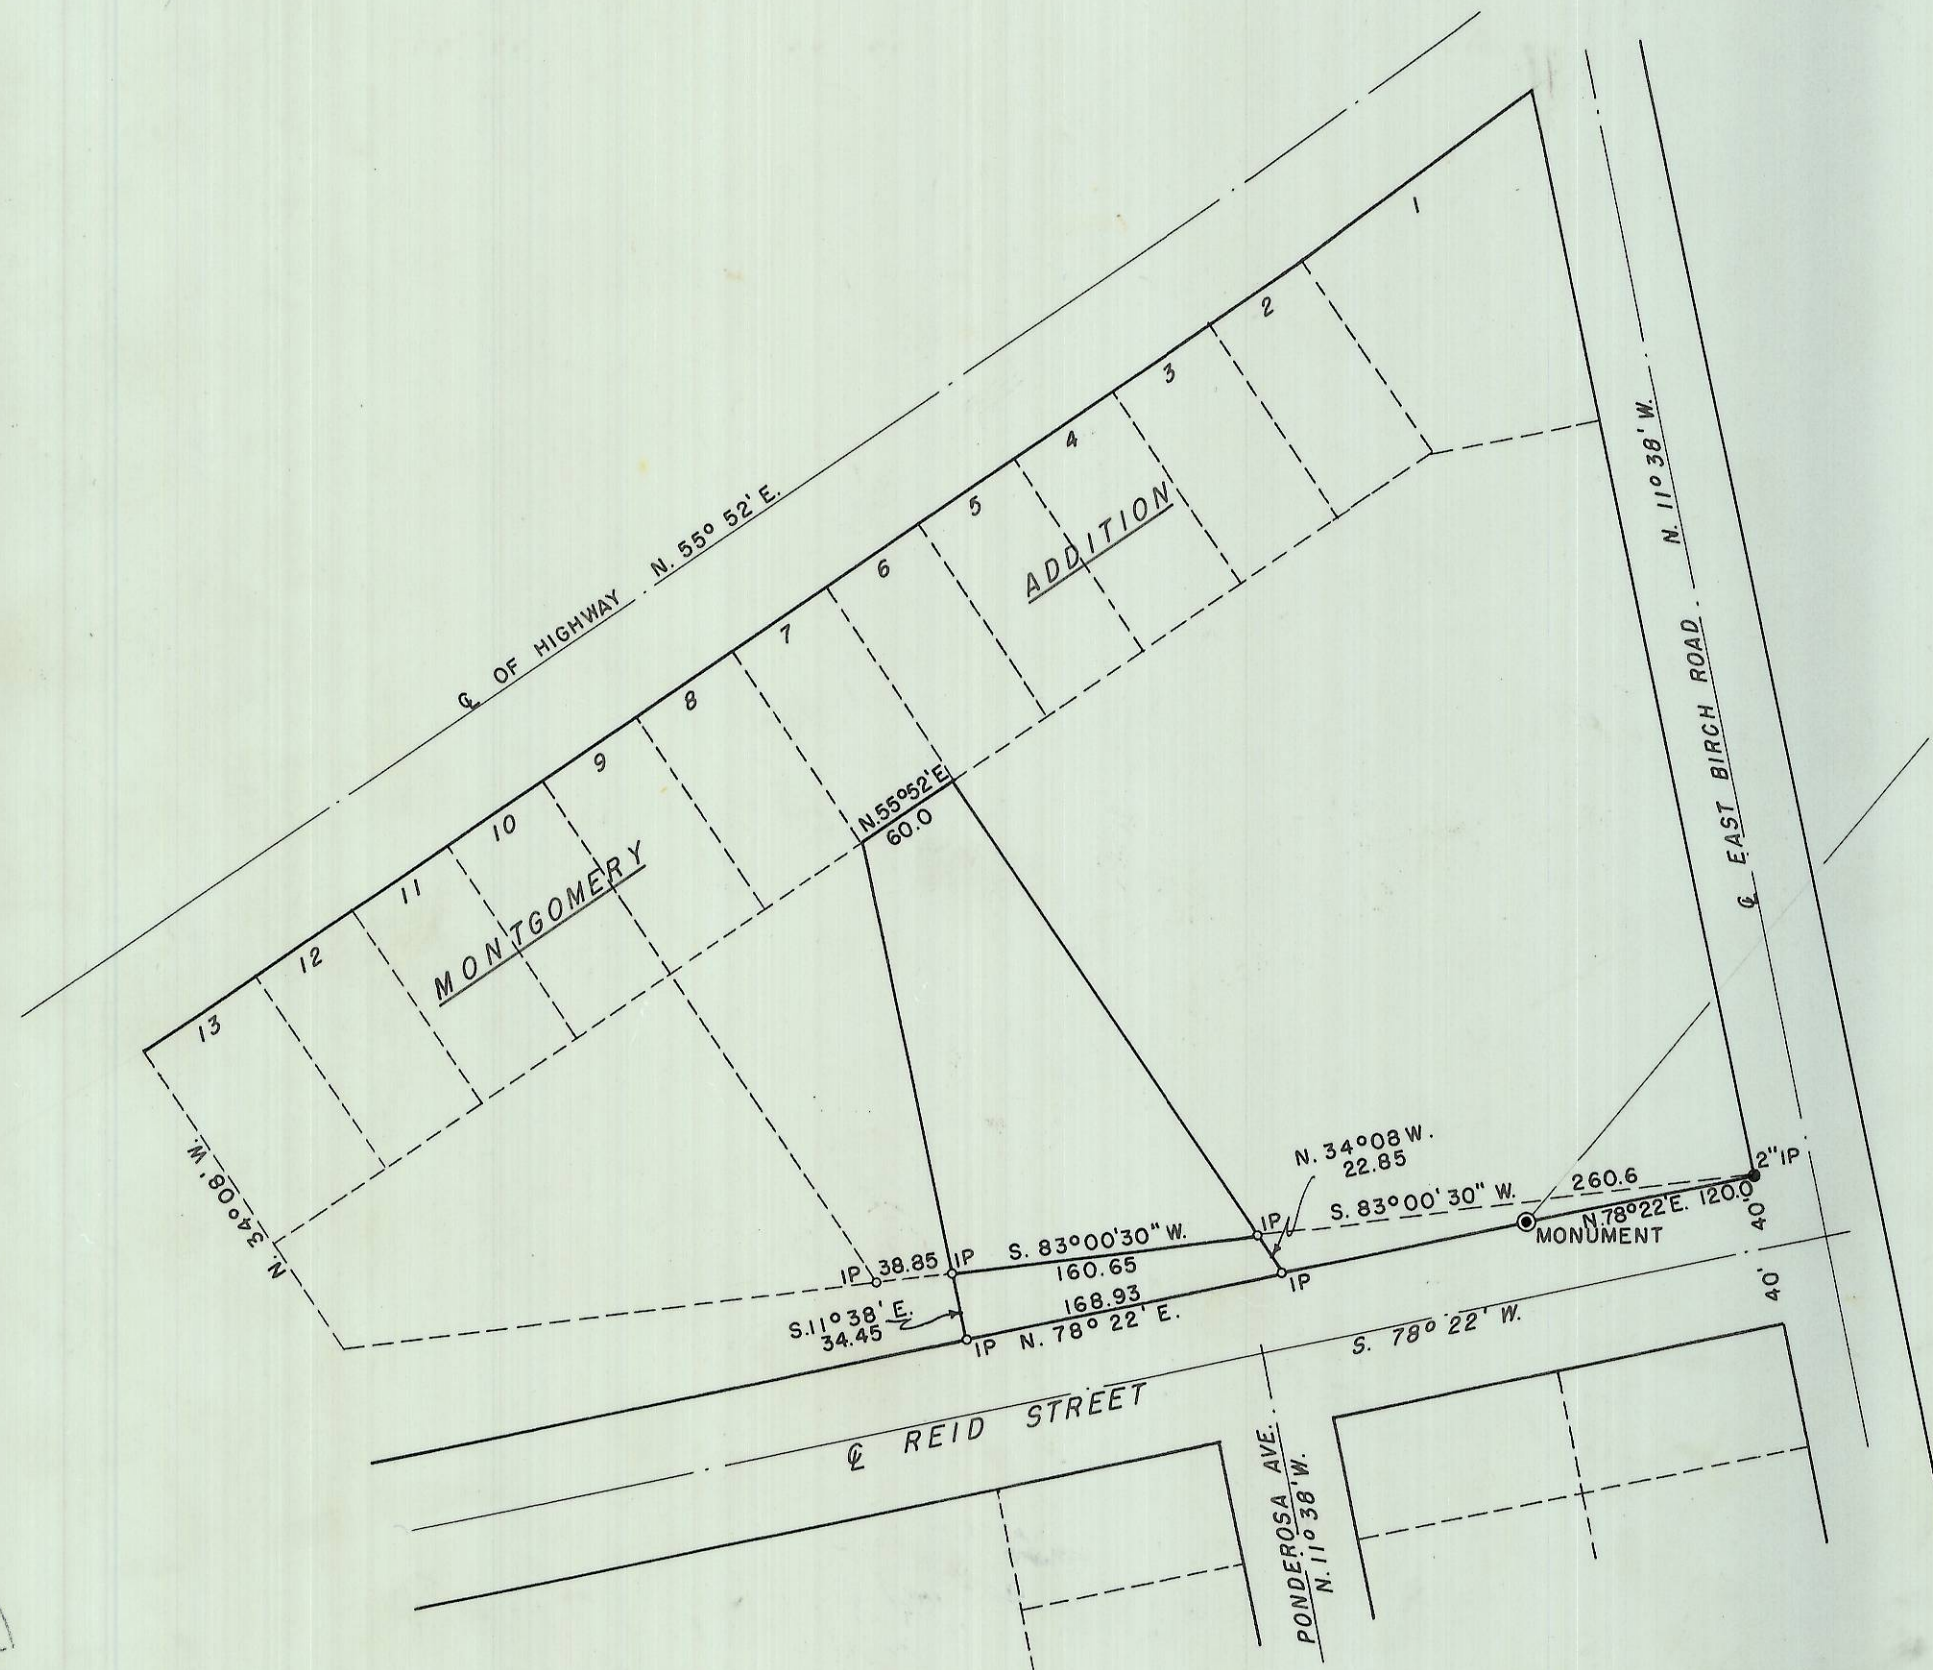

T15 R32 17

HAYES & HARRIS ENGINEERING		
SURVEY FOR EVERETT MONTGOMERY		
PROPERTY LOCATED IN MONTGOMERY ADDITION, CITY OF PILOT ROCK, ORE.		
Scale	Date	Drawn By
1" = 100'	9/24/54	m.p. bemis

Q-872-A 34-0