


6-880-11

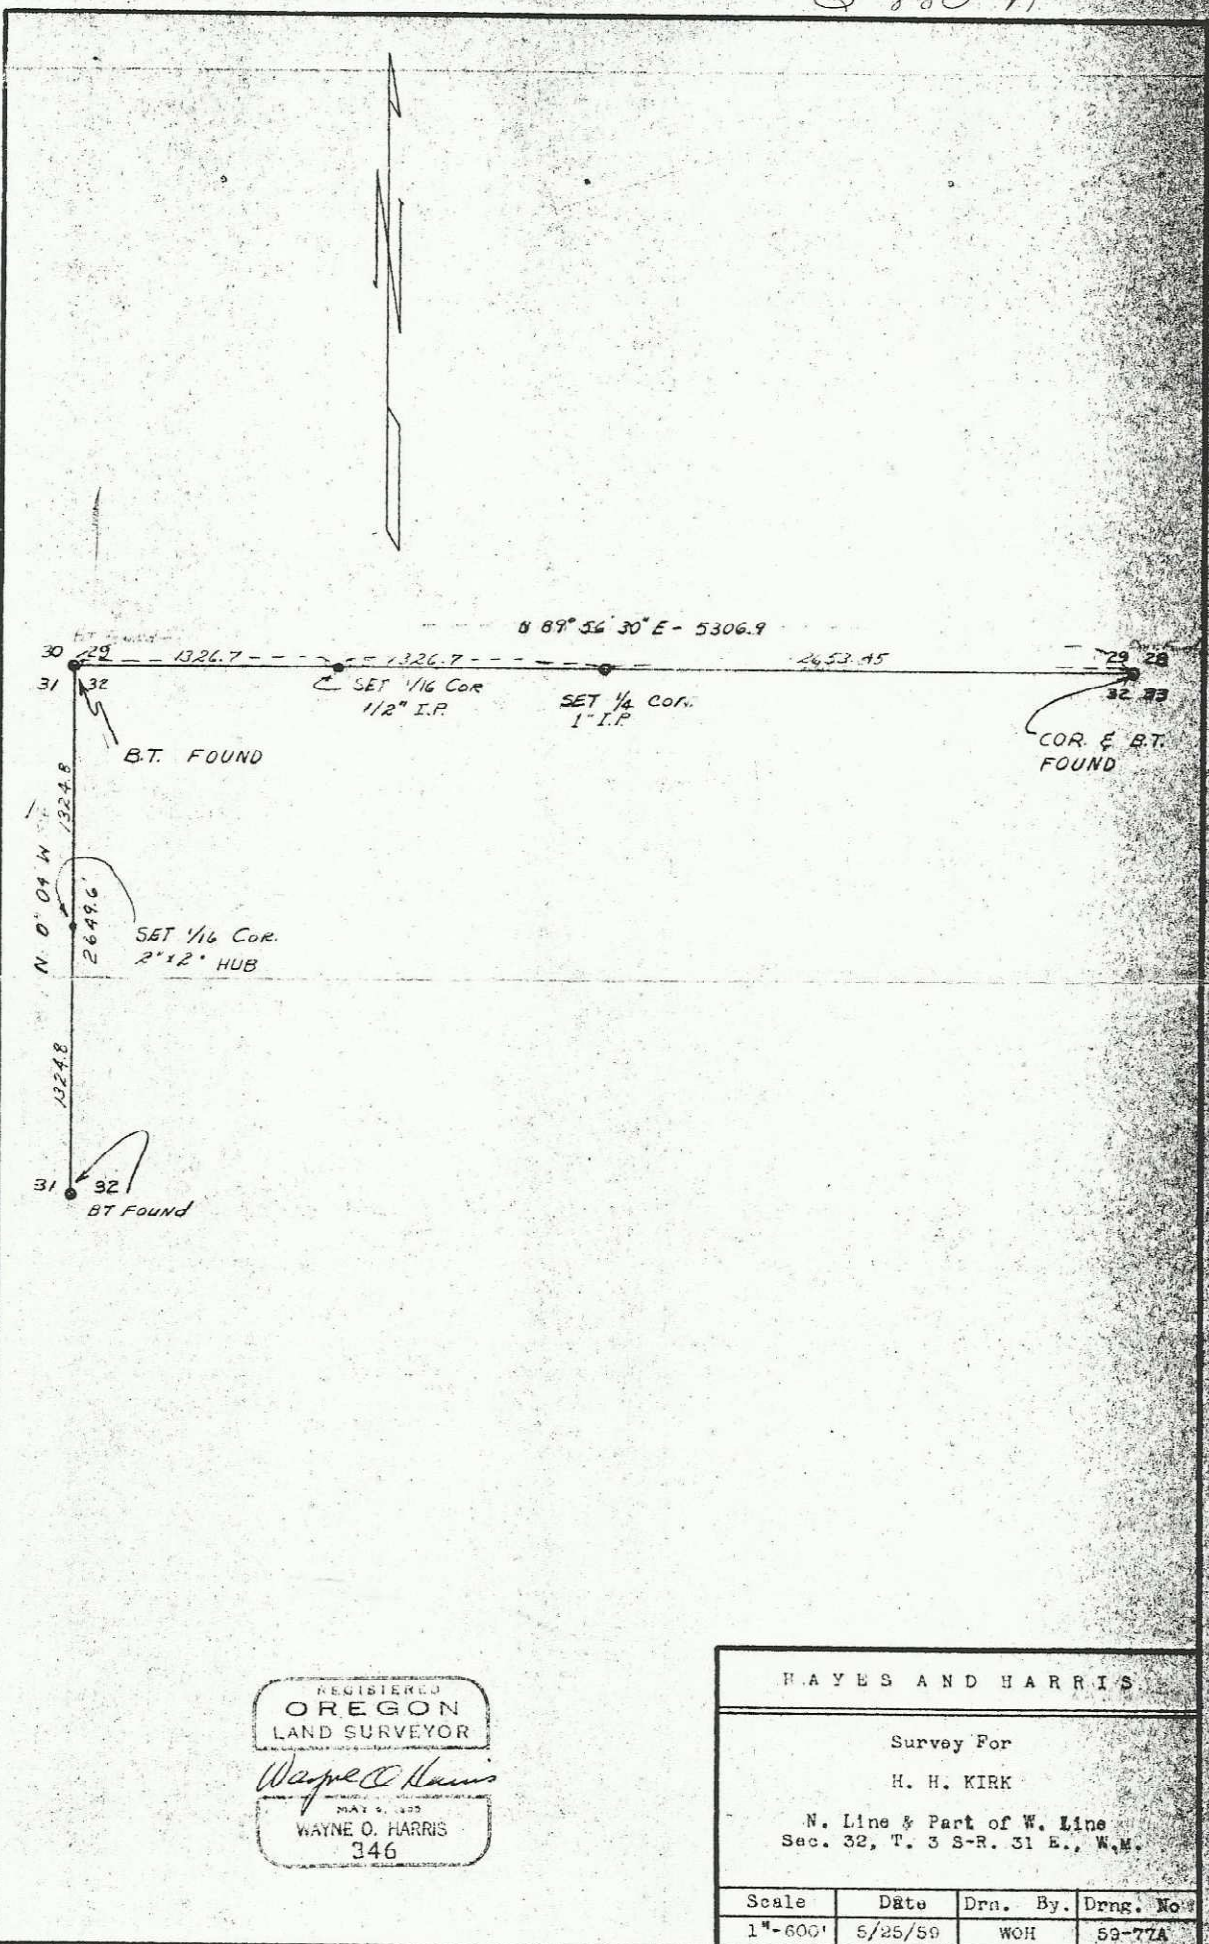

REGISTERED  
**OREGON**  
 LAND SURVEYOR  
*Wayne O. Harris*  
 MAY 6, 1955  
 WAYNE O. HARRIS  
 346

HAYES AND HARRIS			
Survey For H. H. KIRK			
N. Line & Part of W. Line Sec. 32, T. 3 S-R. 31 E., W.M.			
Scale	Date	Drn. By.	Drng. No.
1"=600'	5/25/59	WOH	59-77A