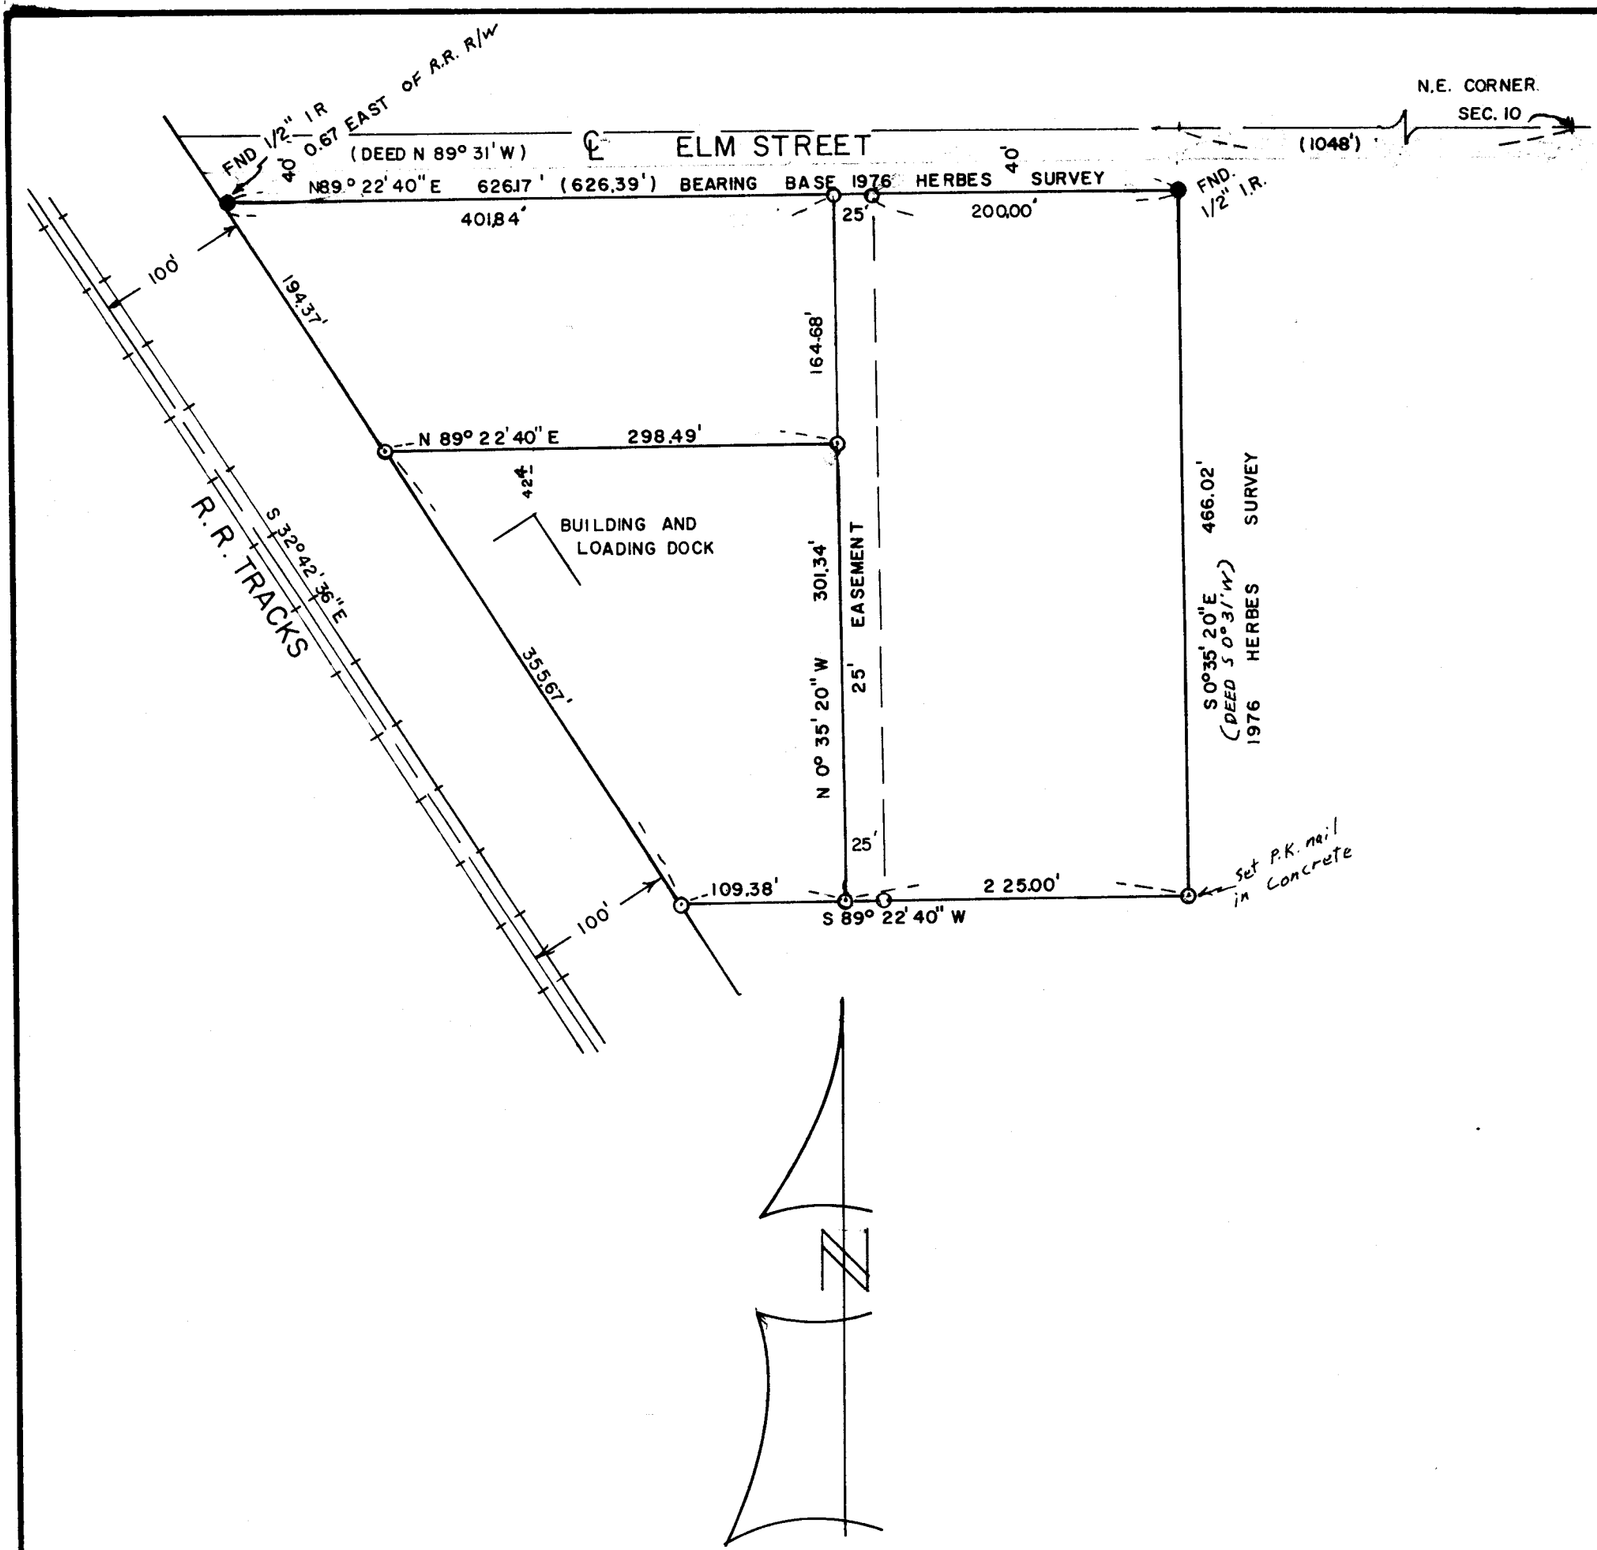

REGISTERED PROFESSIONAL LAND SURVEYOR

G. Dennis Edwards

OREGON
JULY 16, 1971
G. DENNIS EDWARDS
951

Q-1110-A, Q-1151-A

SURVEY FOR BERG BROTHERS

LOCATION N E 1/4

SEC. 10, T 4 N, R 28 E. W.M., UMATILLA COUNTY, OREGON

DATE 5-1-79 SCALE: 1" = 100'

● MONUMENTS FOUND (000) OF RECORD

O 1/2" IRON RODS SET JOB NO. S 7904106

EDWARDS SURVEYING
567-3336
P. O. Box 763
Hermiston, Ore.