

SEC. 13 T. 5 N. R. 35 E. W. M.
SEC. 18 T. 5 N. R. 36 E. W. M.

NW 1/4 Cor.
Sec. 18

S89°30'W. 244'

Iron Pin

Iron Pin

N5°08'E. 192'

N26°10'W. 503'

N53°5'

Iron Pin

Albert & Flossie Geiss

Iron Pin

N23°51'W. 138'

Iron Pin

N1°16'W. 208'

Iron Pin

N8°51'W. 190'

Iron Pin


N9°27'W. 212'

Iron Pin


N88°19'E. 622'

Old Fence

Fence Cor.

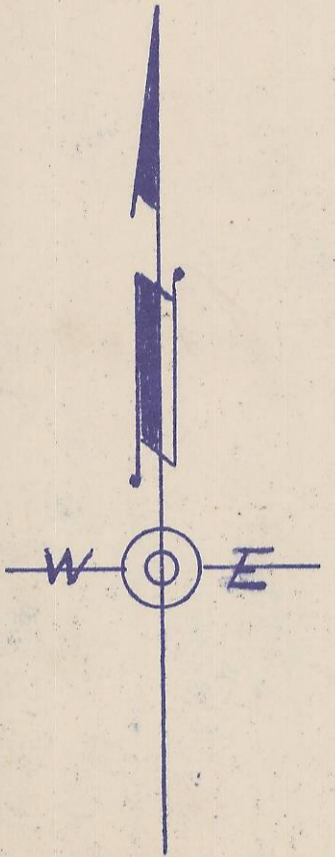

North 1333'

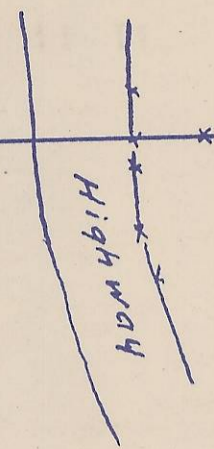

Old Fence Cor.

Walter W. & Marie Wagner

Old Fence
X On Rock 3x6 ft in diameter
70' above bed Couse Creek
On West bank.

Heinz

SW 1/4 Cor.
NW 1/4 SW 1/4
Sec. 18

Fence Cor.
Iron Pin

PLAT
OF

THE N.W. 1/4 of THE SW. 1/4
OF SECTION 18 T. 5 N., R. 36 E. W. M.
IN UMATILLA COUNTY OREGON
Showing Boundary Line Of Properties
Adjacent To Couse Creek
Surveyed, Staked & Platted April 1951
By H. L. Melton, Reg. Prof. Engineer Ore No. 1337
Scale 1" = 100 ft.



Field Notes

April 25, 1951

Beginning at the $\frac{1}{4}$ Corner common to Section 13 T 5 N. R 35 E. W. M. and Section 18 T 6 N. R 36 E. W. M I ran South 1333.0 feet to the S. W. Corner of the N. W. $\frac{1}{4}$ of the S. W. $\frac{1}{4}$ of Section 18; Thence N $88^{\circ}19'E$. along old fence line 622.0 feet; Thence N $9^{\circ}27'W$. 212.0 feet to a Rock 3'x6' in diameter 7.0 ft. above the bed of Couse Creek on the West bank thereof and marked with a X; Thence N $8^{\circ}51'W$. 190.7 ft; to an iron pin; Thence N. $21^{\circ}16'W$. 208.8 ft to an iron pin; Thence N. $23^{\circ}52'W$. 138.6 ft. to an iron pin; Thence N. $26^{\circ}10'W$. 452.6 ft to an iron pin; Thence N. $5^{\circ}09'E$. 192.0 ft. to an iron pin; Thence S. $89^{\circ}30'W$. 244.0 ft to the point of beginning.

Plat accompanying notes.

N. L. Melton

Q-1639-A