


BEARINGS AND SURVEY ARE  
 BASED ON 1977 DRIVER  
 SURVEY. BEARINGS ARE  
 TRUE.

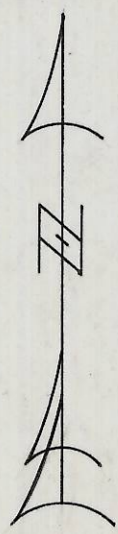

REVISED 3-20-80

REGISTERED  
 PROFESSIONAL  
 LAND SURVEYOR

*G. Dennis Edwards*

OREGON  
 JULY 16, 1971  
 G. DENNIS EDWARDS  
 951

REC'D BY  
 (DRIVER) I.R.

Umatilla County Surveyor

Date 4-14-80

Rec'd By ELS

No. R-54-A

SURVEY FOR R. AND P. JONES

LOCATION NW 1/4

SEC. 5, T 4 N, R 29 E, W.M., UMATILLA COUNTY, OREGON

DATE 7-28-77  
 REVISED 3-20-80

SCALE: 1" = 100'

● MONUMENTS FOUND

(000) OF RECORD

○ 1/2" IRON RODS SET

JOB NO. S7707213A

EDWARDS SURVEYING

567-3336

P. O. Box 763

Hermiston, Ore.

R-54-A