

BEARINGS & SEC. BREAKDOWN ARE BASED ON 1976 PALMER SURVEY FOR WALCHLI (File # M-43-B)


5 4 ---
 FND. 5/8" I.R. 8 9 2604.26
 --- S 89° 30' 24" W 6518.31 (6517.43) ---
 S 89° 28' 15" W 5208.51 (5207.81) 4 3 1309.81' (1309.63)
 FND 1 1/2" I.R.

EDWARDS RD.
(N 0° 32' 50" E 5323.16')

S 0° 00' 46" W

S 0° 04' 34" E

(S 0° 09' 55" E 5322.34')

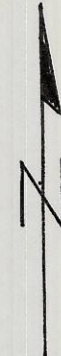

REGISTERED
PROFESSIONAL
LAND SURVEYOR

G. Dennis Edwards

OREGON
JULY 16, 1971
G. DENNIS EDWARDS
951

RECEIVED BY
Umatilla County Surveyor
Date 12-80
Rec'd By BLS
R-182-A

SURVEY FOR VIC AICHELE

IN NE 1/4 SEC. 9, T4N, R29E, W.M,
UMATILLA CO., ORE.

DATE: 10/23/80 SCALE: 1" = 600'

● MONUMENTS FOUND (000) of record
○ 1/2" Iron Rods SET Job # 58010226

EDWARDS SURVEYING P.O. Box 763, HERMISTON, ORE.

R-182-A

8 9
17 16

(S 89° 28' 15" W 5273.98')

9 10
16 15