


SURVEY TO SET LOT CORNERS
 IN BL. 85, ORIG. FREEWATER
 MILTON-FREEWATER, UMATILLA COUNTY, OR.
 SURVEYED FOR JOHN SHORT & DALE MUNDON
 SURVEYED BY VICTOR M. McLIND, R.L.S. 934
 MAY, 1981
 SCALE: 1"=50'

FND $\frac{1}{8}$ " BRASS ROD IN CONC.
 IN MON. CASE

FND. R.R. SPIKE

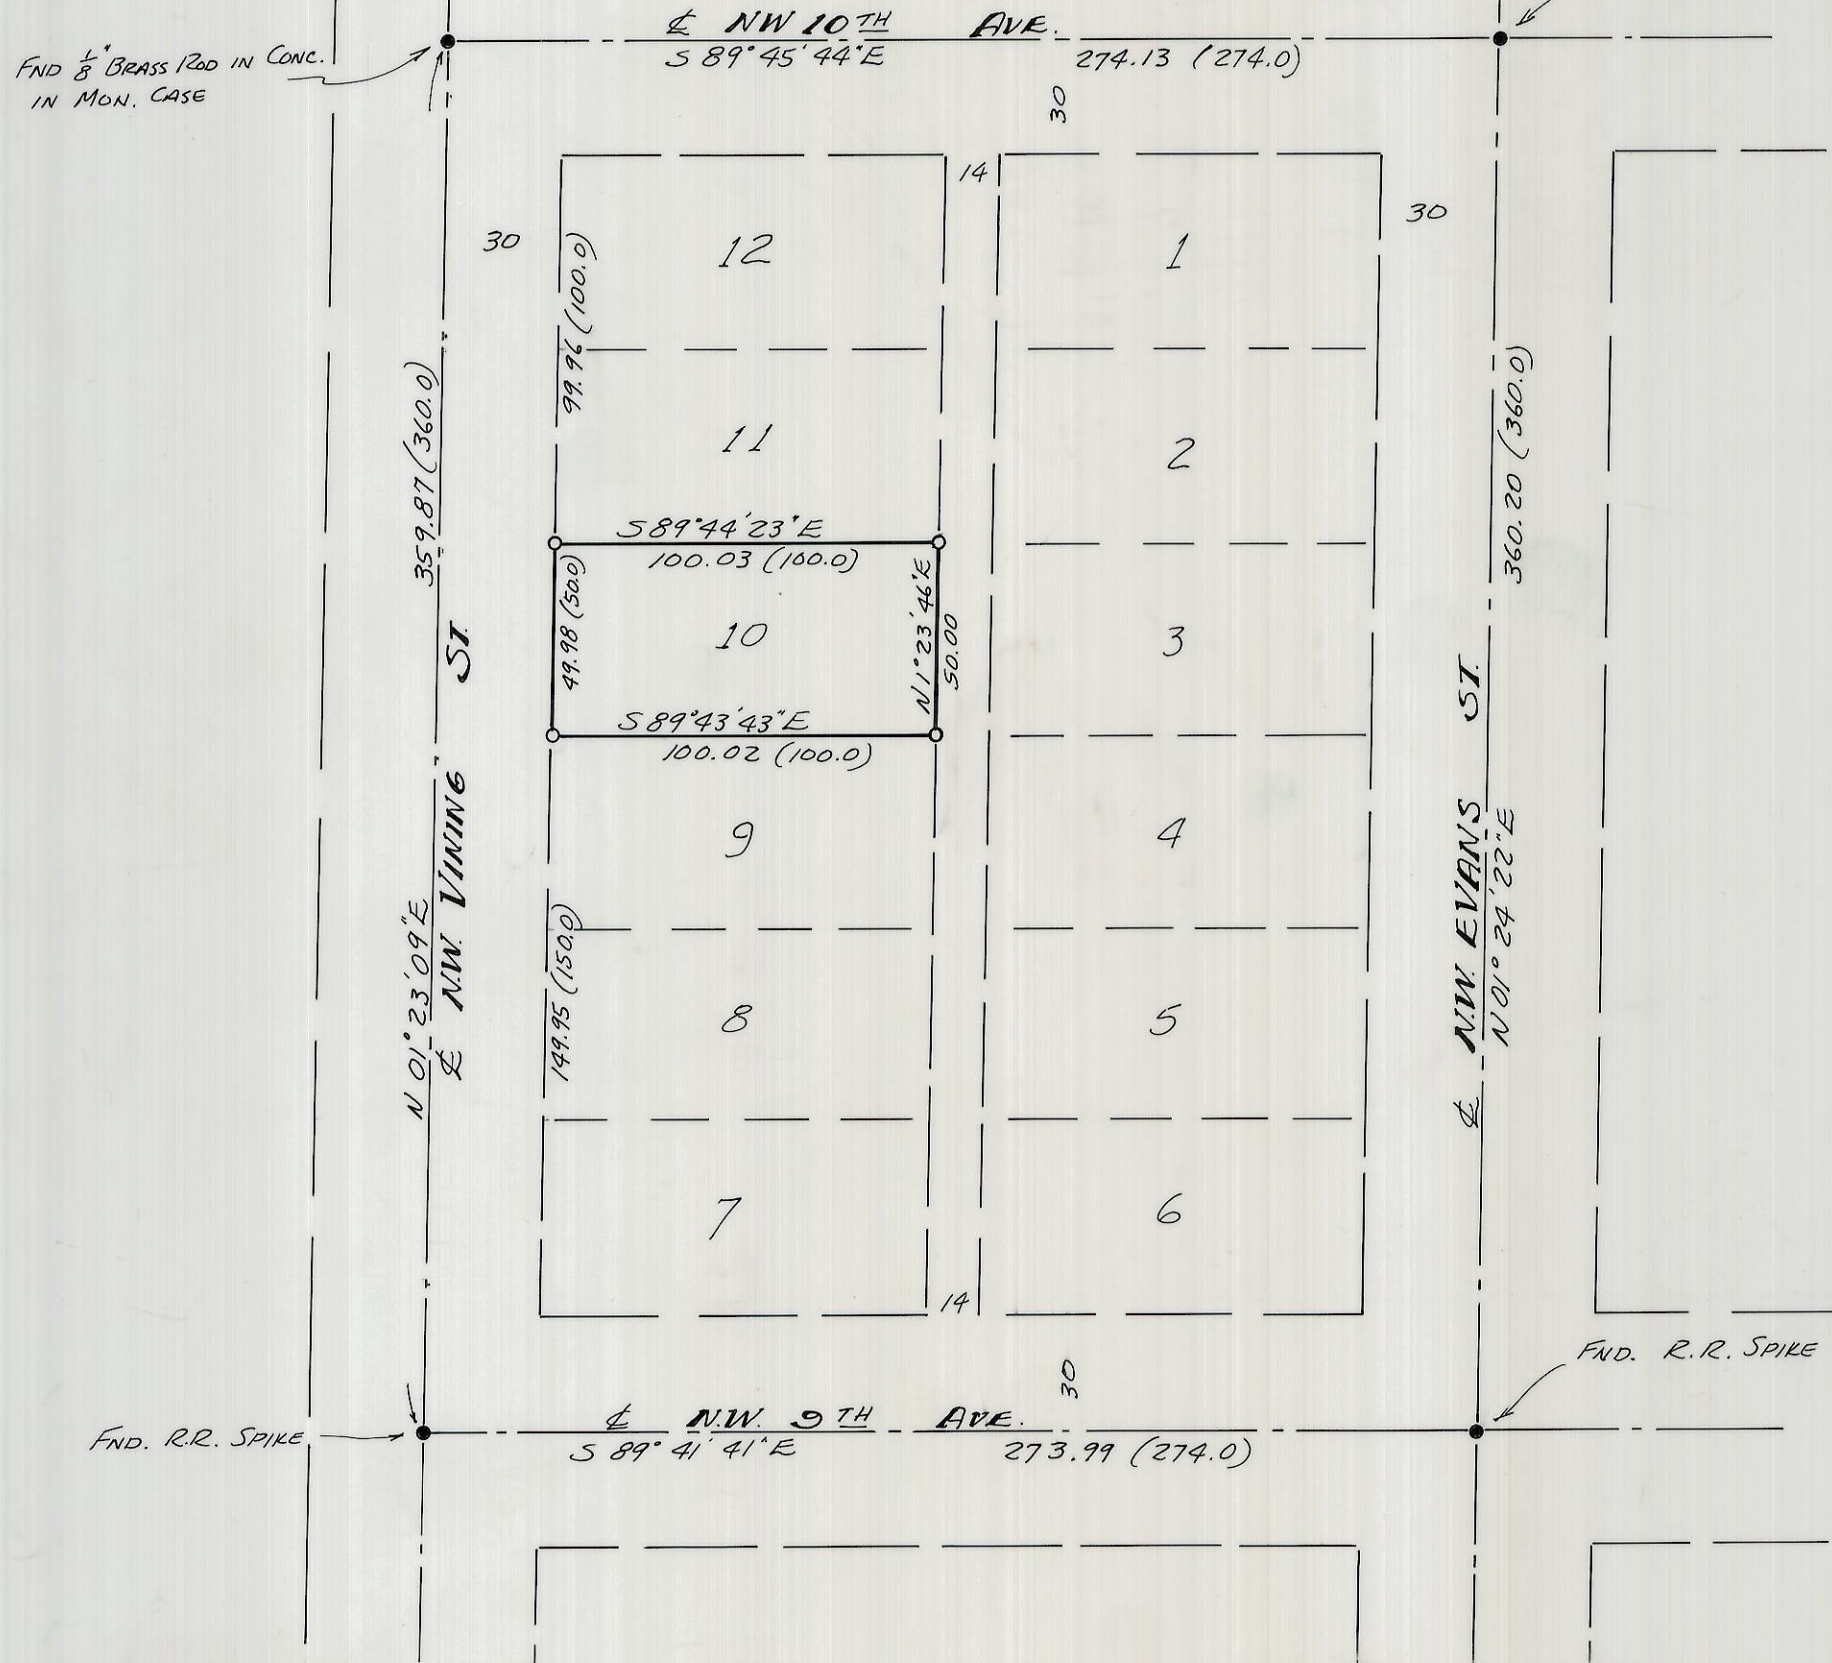

LEGEND

- MONUMENT FOUND AS NOTED
- SET $\frac{5}{8}$ " x 30" STEEL ROD
- () BRACKETS INDICATE RECORD DISTANCE

BEARINGS ARE BASED ON THE WEST LINE
 OF THE NW $\frac{1}{4}$ OF NE $\frac{1}{4}$, SEC. 2, T 5N, R 35E,
 W.M., $N 0^{\circ} 59' 30'' E$, AS PER A SURVEY BY
 STORMS IN 1949.

REGISTERED
 PROFESSIONAL
 LAND SURVEYOR

Victor M. McLind

OREGON
 JULY 17, 1970
 VICTOR M. McLIND
 934

RECEIVED BY
 Umatilla County Surveyor
 Date 6-81
 Rec'd by BLS
 No. S-93-A

S-93-A

NARRATIVE OF SURVEY

SURVEYED BY: Victor M. McLind, Route 3, Box 2, Milton-Freewater, OR 97862

SURVEYED FOR: JOHN SHART AND DALE MUNDON

DATE OF SURVEY: MAY, 1981

LOCATION: BL 85, ORIG. FREEWATER

MONUMENTS FOUND: BR. ROD IN CONC. AT INT. NW 10TH AND VINING ST.;
RR. SPIKES AT INTERSECTIONS 9TH & VINING, 9TH & EVANS,
AND 10TH AND EVANS.

MONUMENTS SET: $\frac{5}{8}$ " x 30" STEEL RE-BAR AT ALL CORNERS LOT 10.

PURPOSE OF SURVEY: TO MARK CORNERS LOT 10, BL. 85, ORIG. FREEWATER

COMMENTS: THE 14' WIDE ALLEY RUNNING THRU THIS BLOCK DOES NOT STRAY
WITHIN ITS R/W. THE BACK CORNERS OF ~~BL~~ LOT 10 FALL ON THE
E. SIDE OF THE ALLEY AS SAID ALLEY IS LOCATED ON THE GROUND.

RECEIVED BY

Umatilla County Surveyor

Date 6-81

Rec'd By BLS

No. S-93-A

REGISTERED
PROFESSIONAL
LAND SURVEYOR

Victor M. McLind

OREGON
JULY 17, 1870
VICTOR M. McLIND
934