

APPLICANTS NAME

DOUG MINTHORN


SITE NUMBER

12

DWELLING UNIT TYPE



BEARINGS AND DIST. ARE TRUE.
BASED UPON TIES TO N.G.S. STA.
MISSION AND BEND. 2.

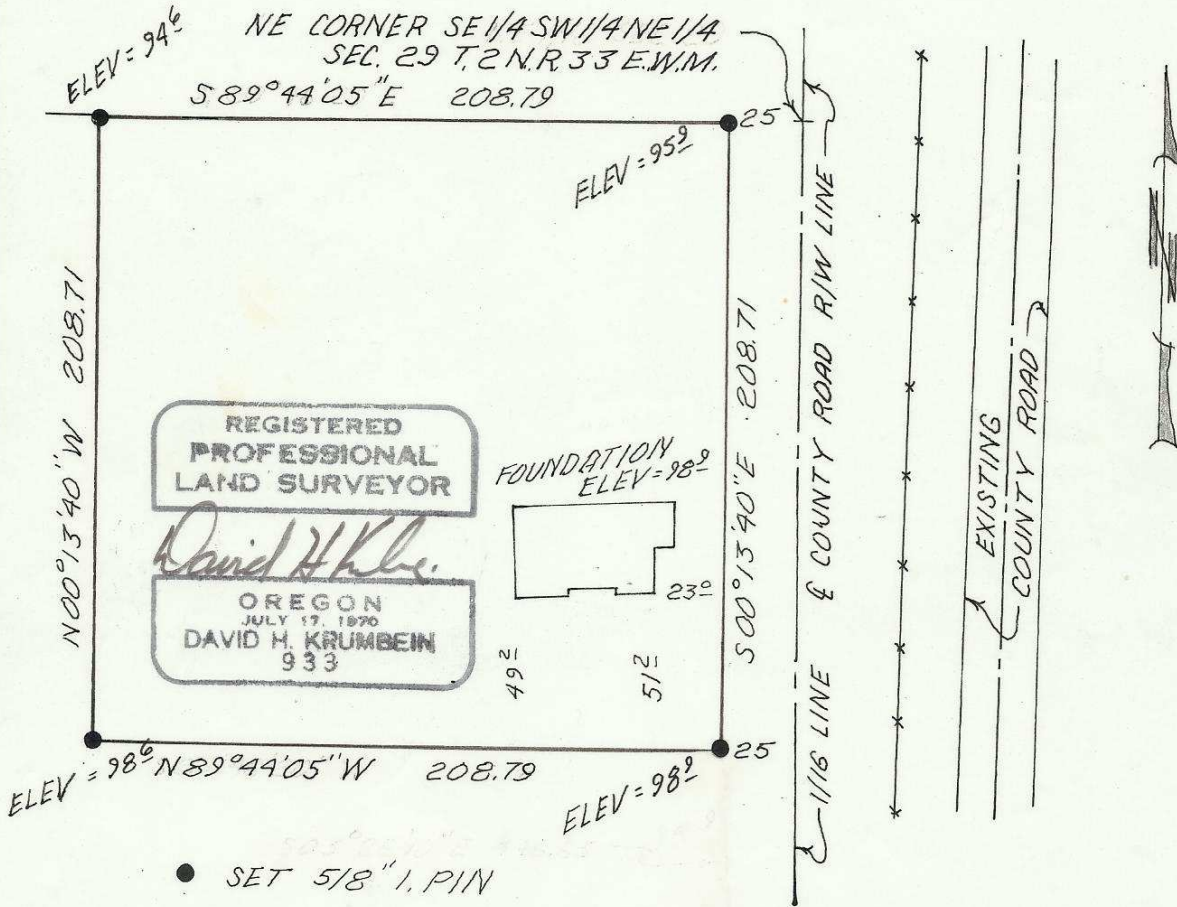

REVISED 1 SEPT 77 JLC

SECT.	MAP	LEGAL DESCRIPTION	NORTH 1" = 60'
		<p>THE NORT DOUG MINTHORN</p> <p>The North 208.71 feet of the East 233.79 feet of the Southeast 1/4, of the Southwest 1/4, of the Northeast 1/4, of Section 29, Township 2 North, Range 33 East W.M. Excepting the East 25.00 feet for a road Right of Way.</p> <p>Containing: 1.00 Acres</p>	

83-98-AY