


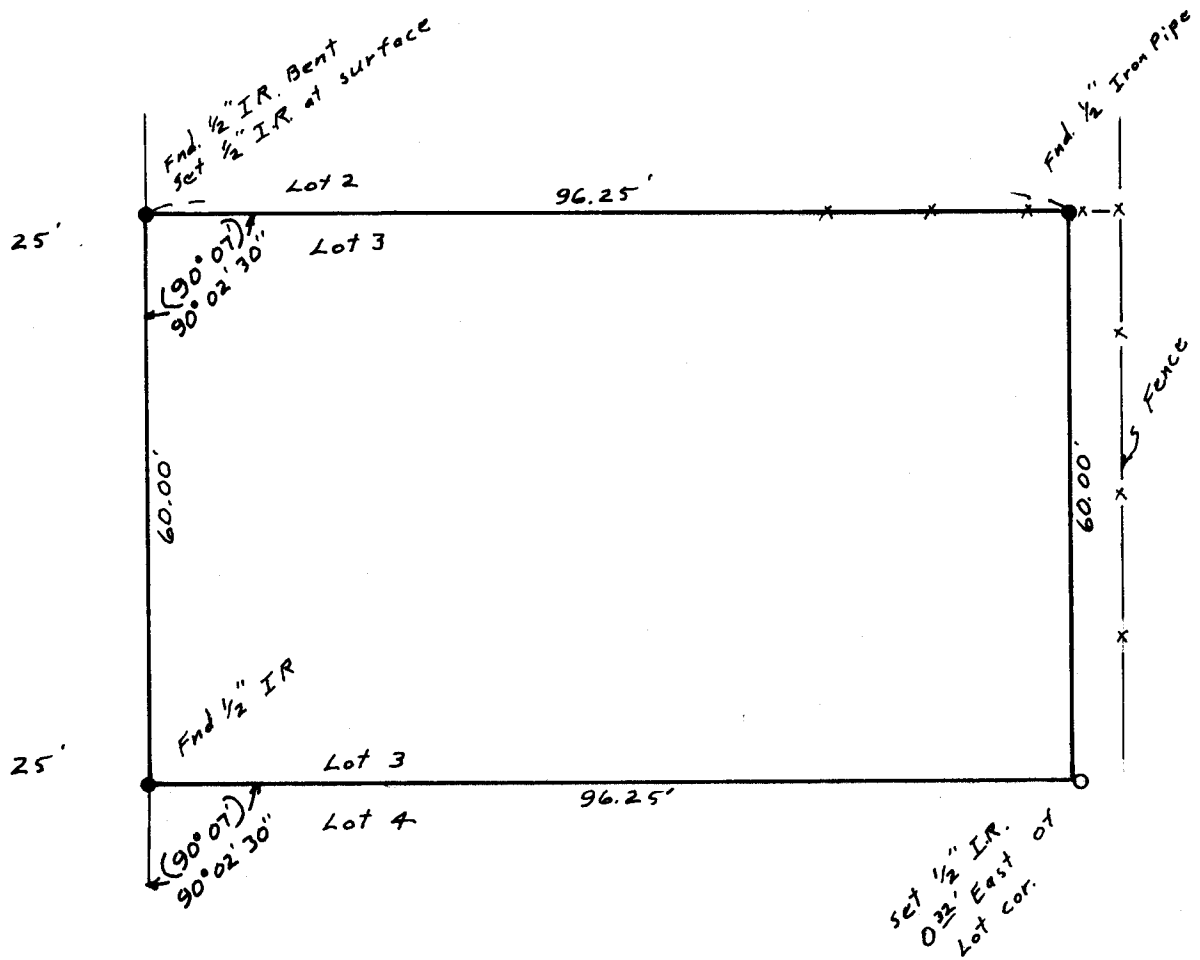

7th PLACE WEST



The purpose of this survey is to stake the south line of Lot 3 for the construction of a concrete retaining wall. The found iron rods are probably original corners of "Vickers Add" set in 1951 & the found iron pipe is probably from a more recent survey

REGISTERED
PROFESSIONAL
LAND SURVEYOR

G. Dennis Edwards

OREGON
JULY 16, 1971
G. DENNIS EDWARDS
951

IN
SURVEY FOR BOB BEDFORD
IN BIK "D" VICKERS ADD. to HERMISTON
IN NE 1/4 SW 1/4 Sec. 10, T4N, R28E, W.M.
UMATILLA CO., OREGON.
6/11/83 Scale: 1" = 20'
(000) of record Job# SB306047

EDWARDS SURVEYING P.O. Box 763
567-3336 HERMISTON, OR.

83-136-AX