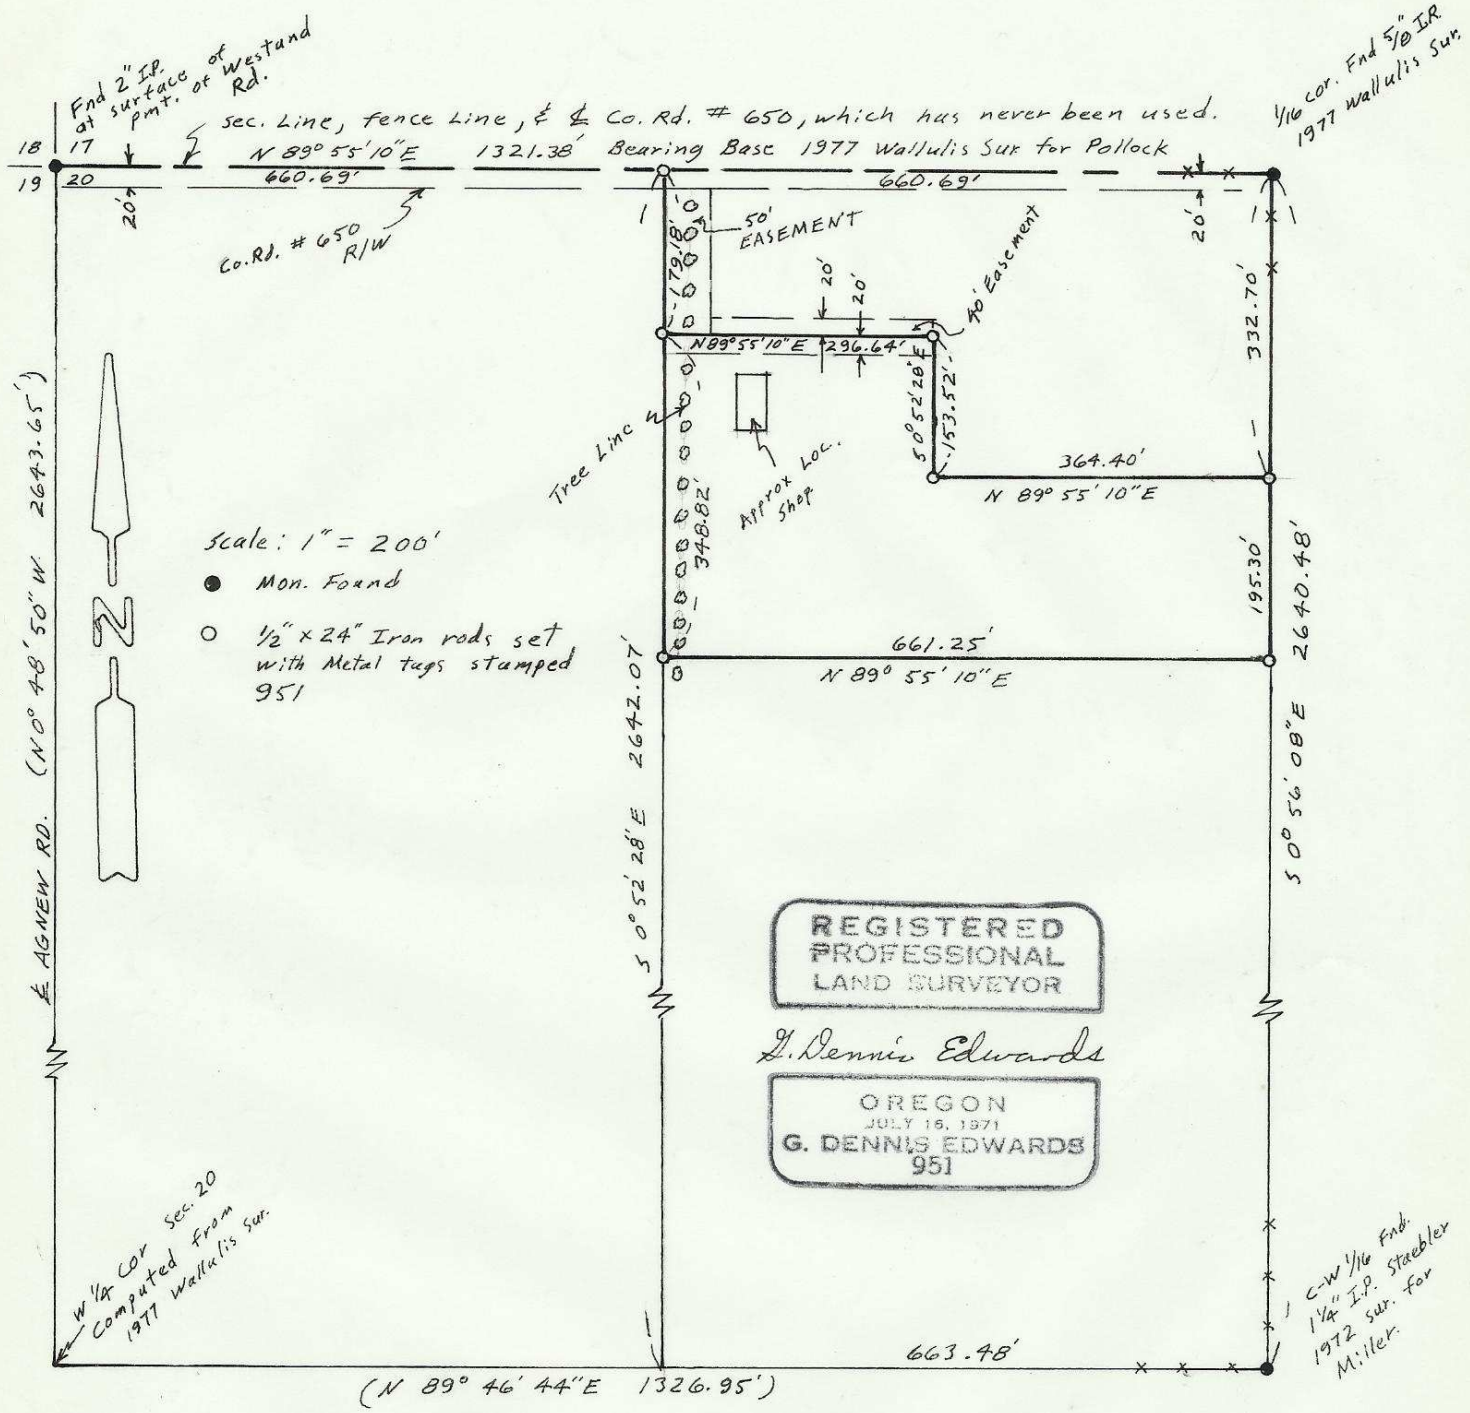


NARRATIVE: The purpose of this survey is to partition two 4 Acre parcels, with houses, out of the W 1/2 of the NW 1/4 of Sec. 20, T 4 N, R 28 E, W.M.

Said W 1/2 was surveyed by S. Wallulis in a 1977 survey for Pollock, (Co. file # M 20-AX) and this survey is based on that 1977 survey.

In a 1979 Sur. for Griffitts, W. Cramer set the SE Cor. of Sec. 20 a distance of 26' ± west of where it was in 1977. That would move the C-W 1/16 3' ± west of where it is. I did not move it.

RECEIVED BY
Umatilla County Surveyor
... to 9/84
...'d By BC
... 84-93-AX

SURVEY FOR LEE & LANE POLLOCK
IN NW 1/4 Sec. 20, T 4 N, R 28 E, W.M.
UMATILLA COUNTY, OREGON
6/20/84 Job # S8406057 (000) of Record

EDWARDS SURVEYING P.O. Box 763
567-3336 HERMISTON, OR.

84-93-AX