


STAKED LINE FOR FENCE

LAWERNCE KLIEN

25' VACATED PORTION OF COUNTY ROAD #598

REGISTERED  
**OREGON**  
 LAND SURVEYOR  
*Wayne D. Harris*  
 WAYNE D. HARRIS  
 346

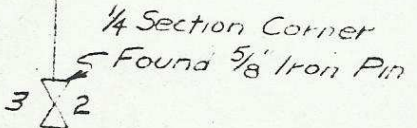

Original

RECEIVED BY  
 Umatilla County Surveyor  
 Date 8-94  
 Rec'd By KK  
 No. 94-107-Ax

HAYES AND HARRIS			
SURVEY FOR LAWERNCE KLIEN			
WEST LINE OF NRTHRLY 12.75 ACRES OF LOT 4, SECTION 2, T. 4 N., R. 28 E., N.M.			
SCALE	DATE	DRN. BY	DRNG. NO.
NONE	4-25-62	L.H.A.	62-166