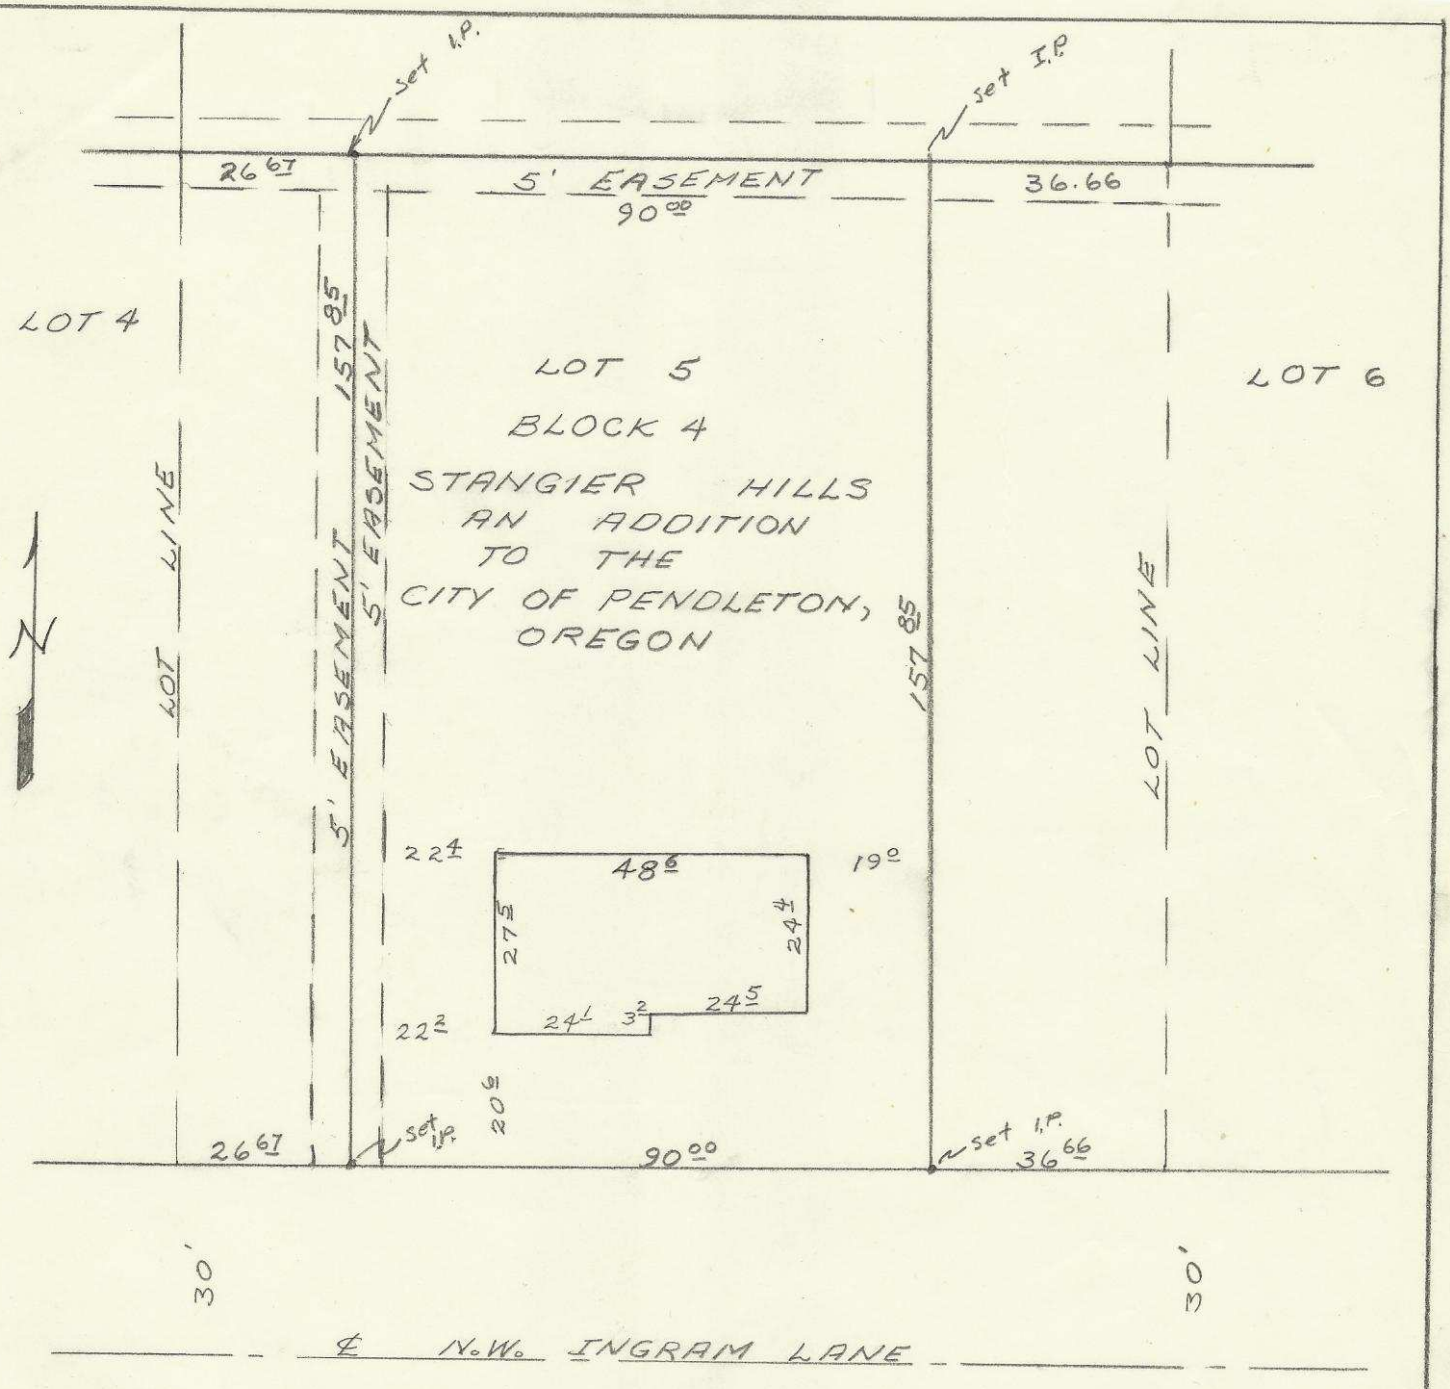

REGISTERED PROFESSIONAL ENGINEER
3758
Stanley G. Wallulis
OREGON
OCT. 22, 1954
STANLEY G. WALLULIS

PLOT PLAN FOR SHERWOOD & ROBERTS	
Scale 1" = 30'	DATE: 10-21-58
STANLEY G. WALLULIS Consulting Engineer	
Pendleton	Oregon

99-192-Ax
2N32-03DA

5 Copies