


# POLK AVENUE

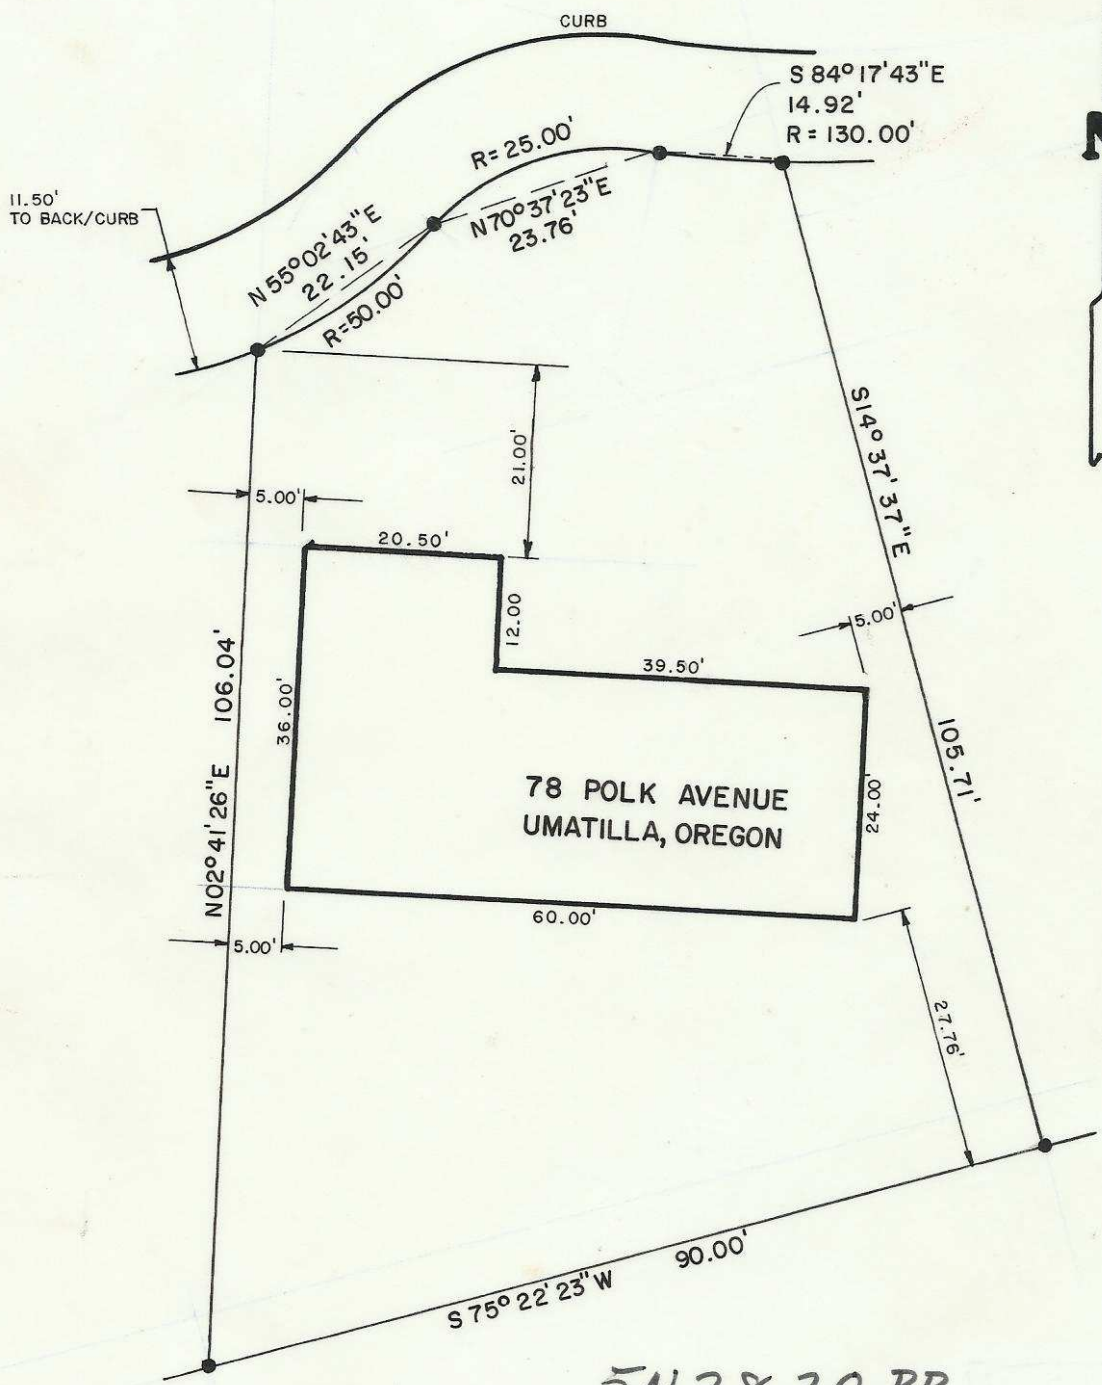

5N 28 20 BB

NORPA DEVELOPMENT, INC. HERMISTON, ORE.

## MORTGAGE SURVEY

LOT 24, BLOCK 4 CONFORTHS FIRST ADDITION

DESIGN	D. N.	CHK	D. S.	SCALE	1" = 20'	DATE	8-19-77
DRAFT	D. N.	APP		JO	77-009	REV.	



04-201-AX

OF