


TYLER AVENUE

5' UTILITY EASEMENT
ADJACENT TO ALL LOT LINES

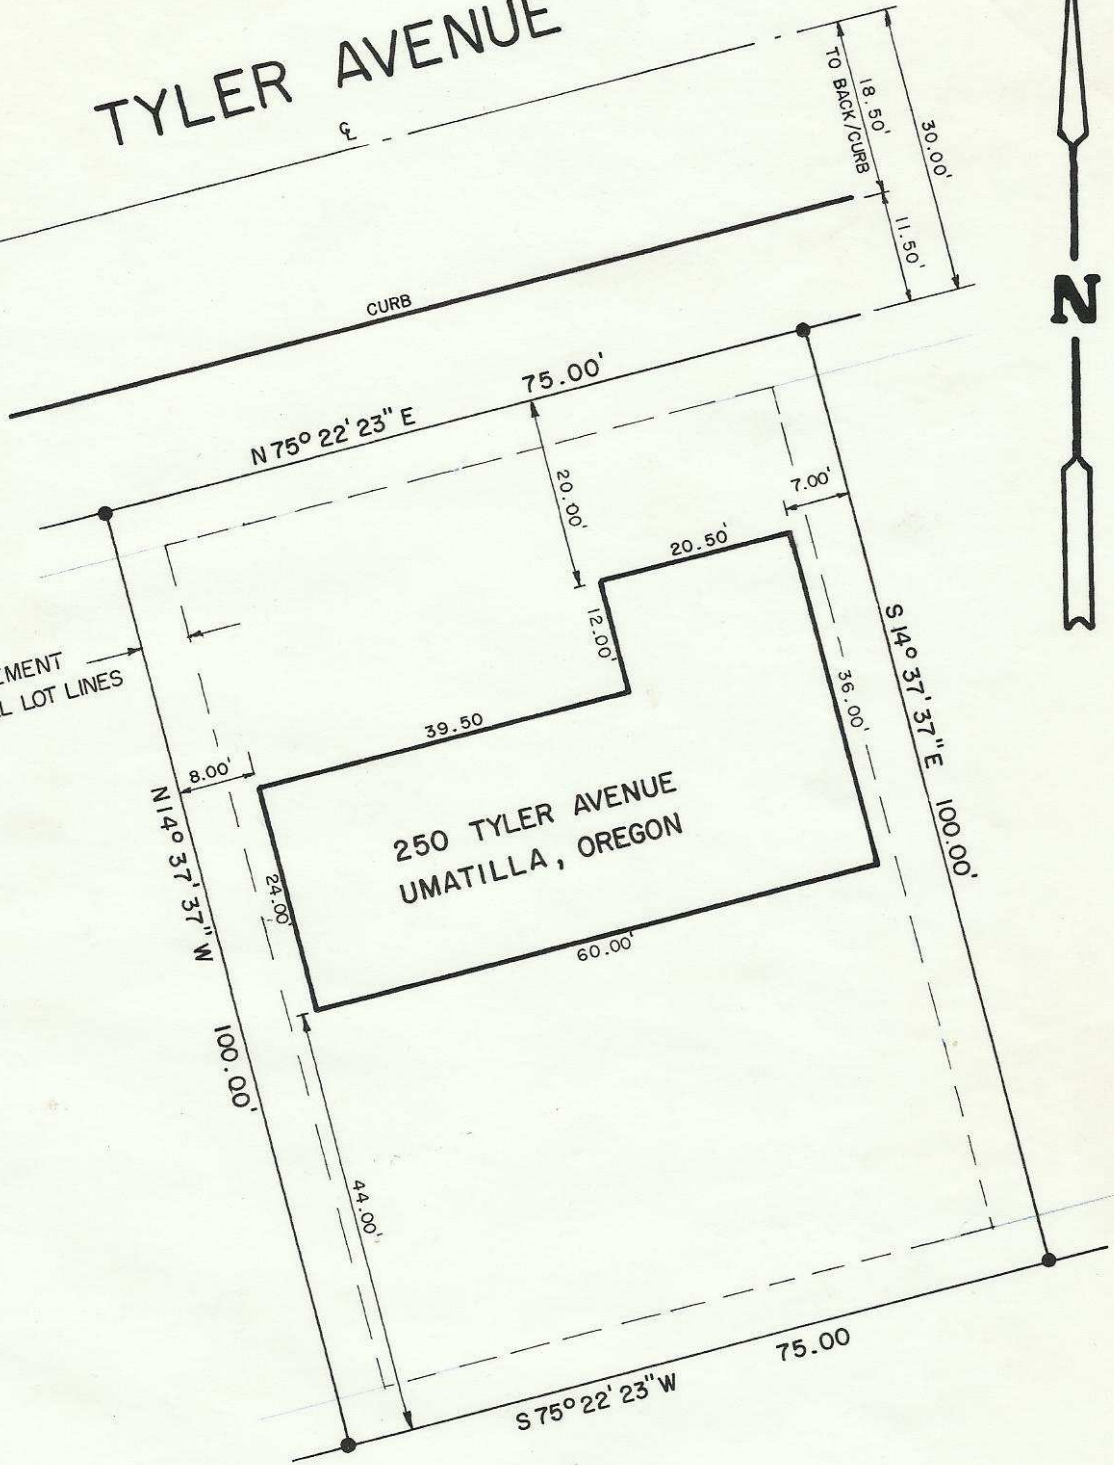


T5N 28 20BB

NORPA DEVELOPMENT, INC. HERMISTON, ORE

LOT SURVEY

LOT 2, BLOCK 4 CONFORTHS FIRST ADDITION

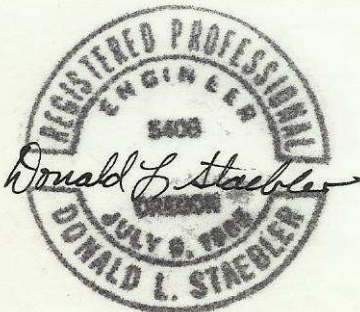

04-202-Ax

DESIGN	D. N.	CHK	D. S.	SCALE	1" = 20'	DATE	8-5-77
DRAFT	D. N.	APP		JO		REV	

OF