


# POLK AVENUE

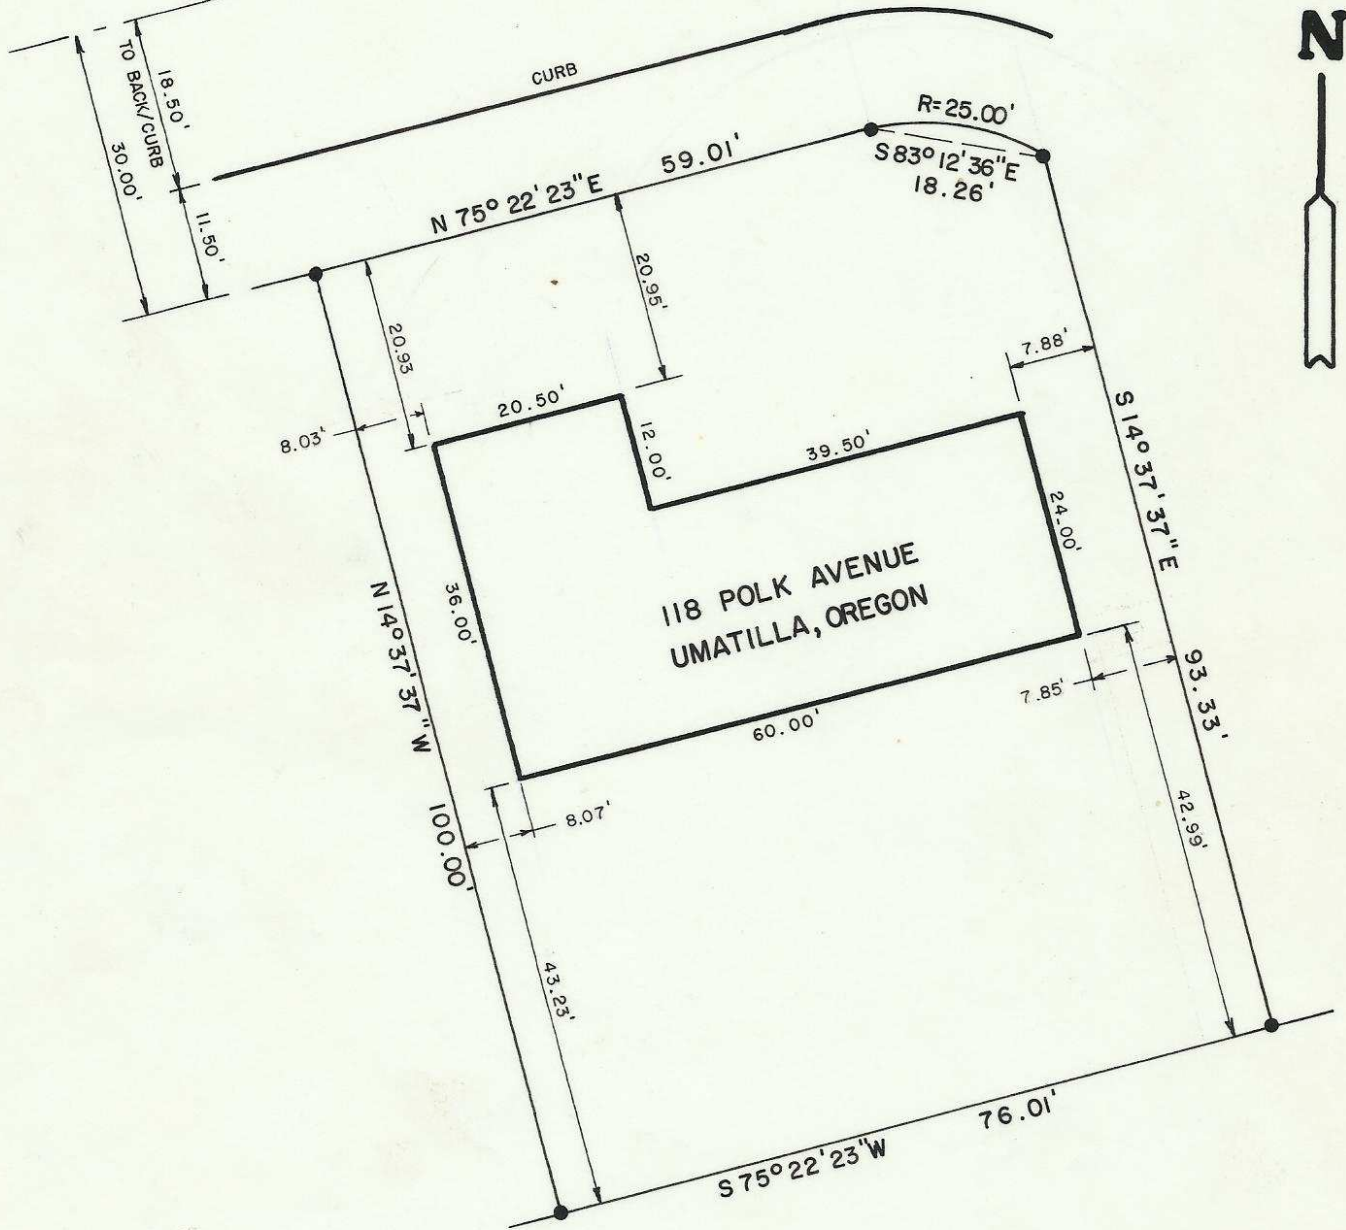

TSN 28 206B


NORPA DEVELOPMENT, INC. HERMISTON, ORE.

## MORTGAGE SURVEY

LOT 20, BLOCK 4 CONFORTHS FIRST ADDITION

|        |       |     |       |       |          |      |         |
|--------|-------|-----|-------|-------|----------|------|---------|
| DESIGN | D. N. | CHK | D. S. | SCALE | 1" = 20' | DATE | 8-19-77 |
| DRAFT  | D. N. | APP |       | JO    | 77-009   | REV  |         |

04-206Ax

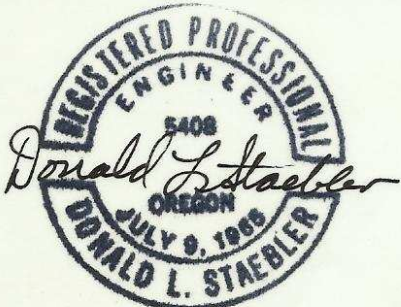

OF