


N.E. 1/4 Sec 25-T. 6N., R34 E.W.M.
Scale 1 inch = 300 Feet.
Surveyed April-May-1946
By W.E.O. Criger.

N.E. Cor. Sec. 25

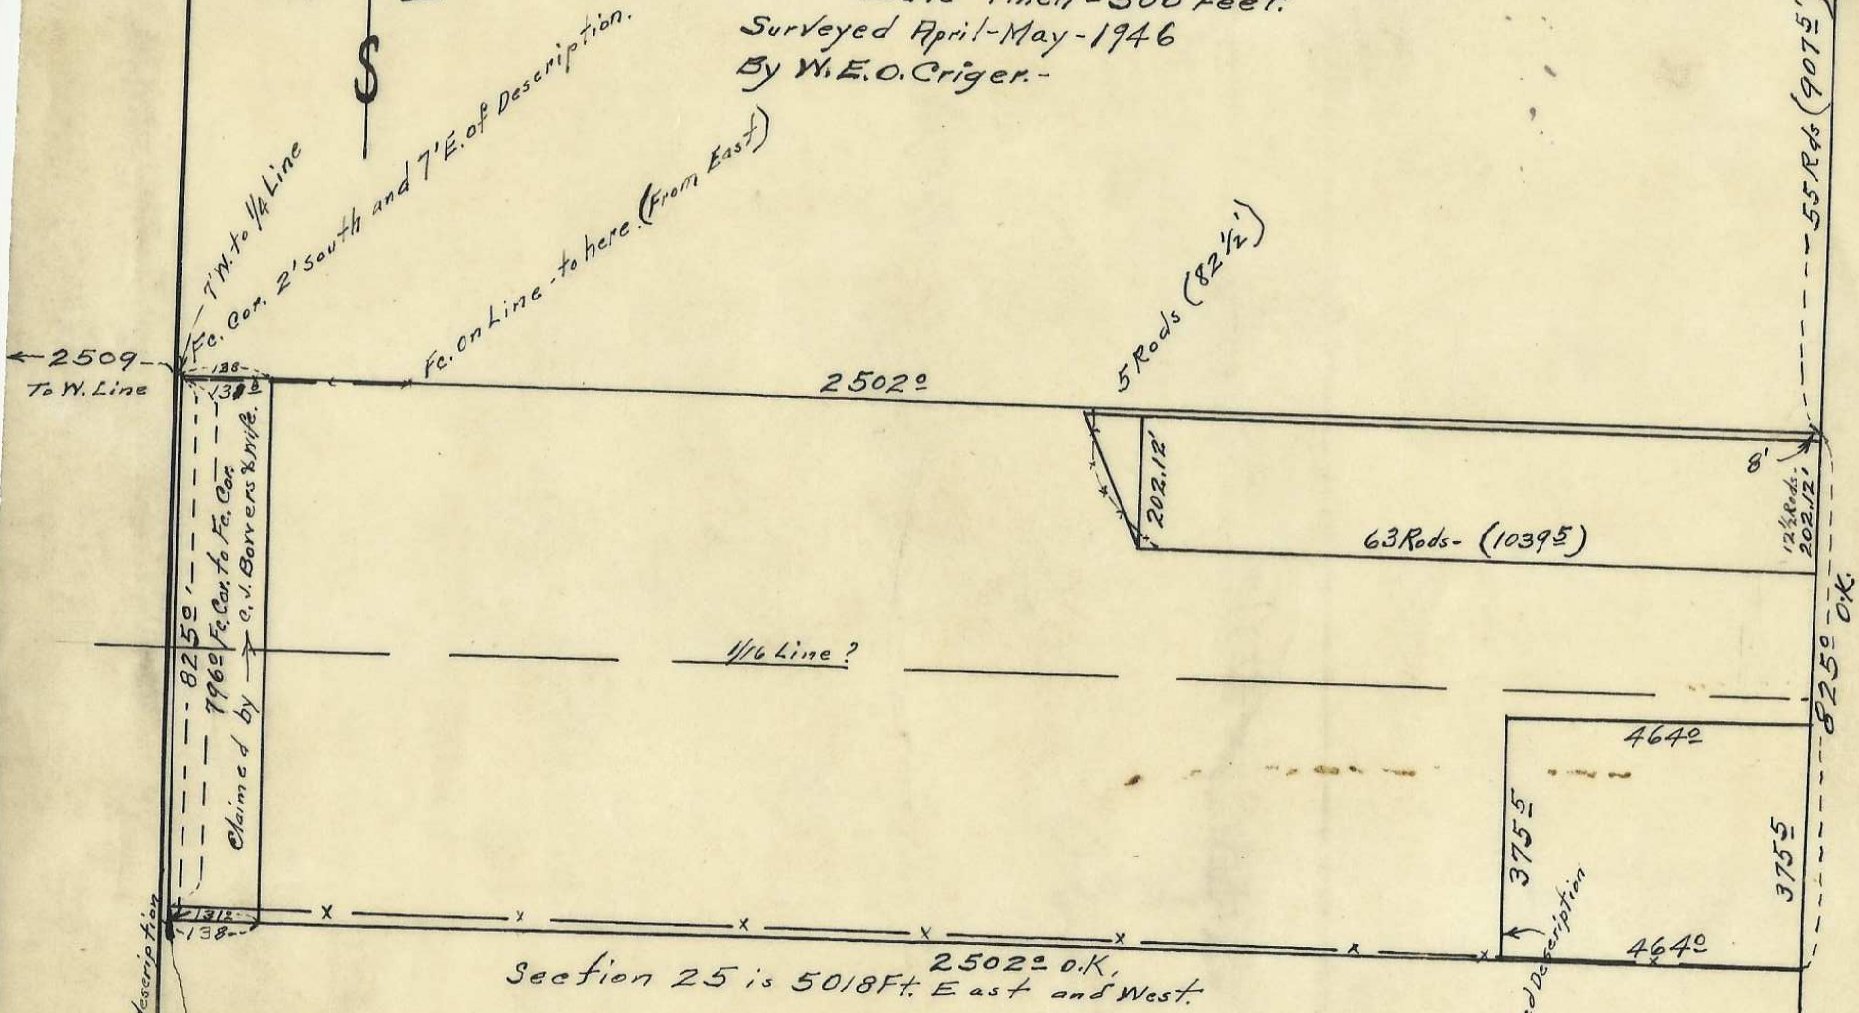

Fe. Cor. 27' N. of Deed description

This fence 6' Foot Deed Description

06-65-Ax