
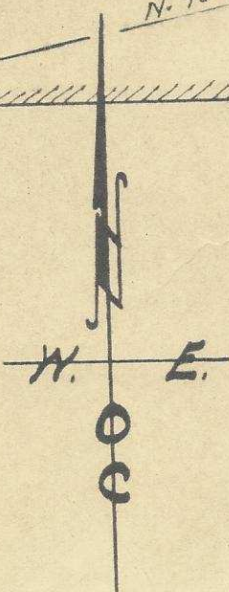
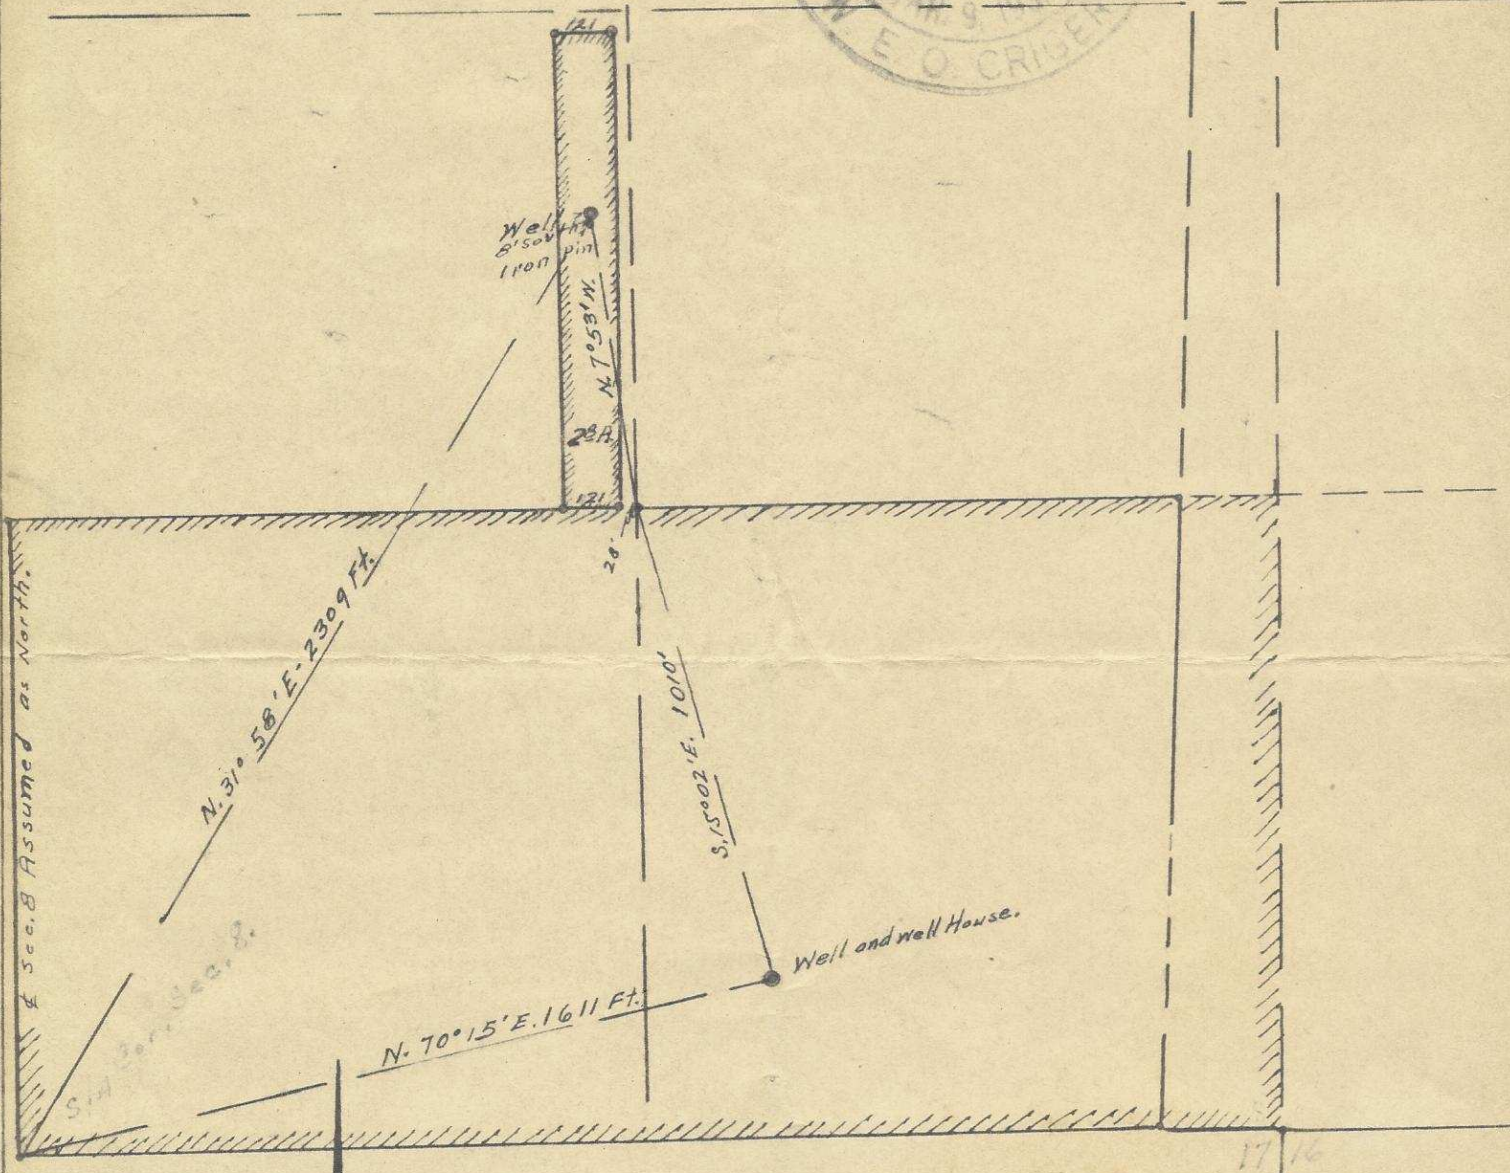


U.S. Hwy - 30

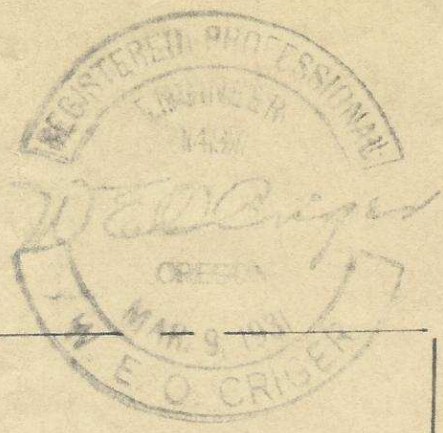

Map showing
Well locations in S.E/4 of Sec. 8
T. 2N., R. 33E.W. M.
Owned operated by B.F. Bowman and Richard Purchase
Surveyed, staked and platted - April - 1952

By W.E.O. Criger.
Scale: 1 inch = 400 Ft.
Application for wells & water right
By Bowman & Purchase -

06-20-Ax