

S. 89°50'15"E

2932

910

2116

1615

Δ 91° 01'
S. 1°10'45"W.
101 26'

Δ 4° 23'
S. 3°12'15"E.
136 54'

Δ 19° 36'
S. 22°48'15"E
156 8


Δ 10° 32' 30"

S. 53° 20' 45" E. 405.19'

Δ 23° 48'

S. 9° 32' 45" E. 322 4'

168 48
S. 78° 04' 15" W. Δ 87° 32' R.

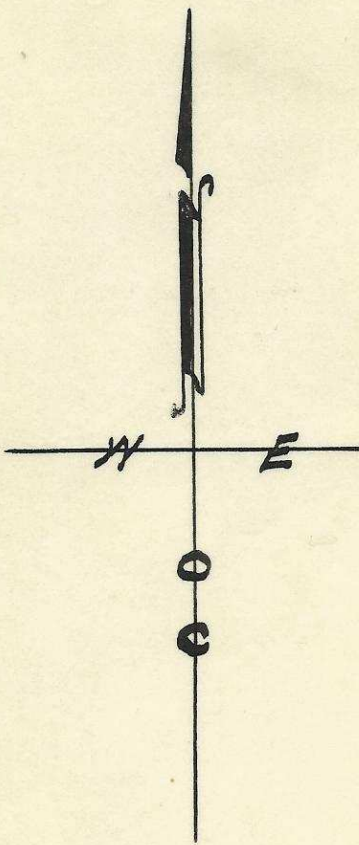

Map of Tract in
 N.W. 4 of Sec. 15, T.2N., R.33 E. W.M.
 surveyed, staked & platted
 March - 1952 - By W.E.O. Criger.
 Scale: 1" = 200'

06-71-Ax