


# Weston Mountain - Timber.

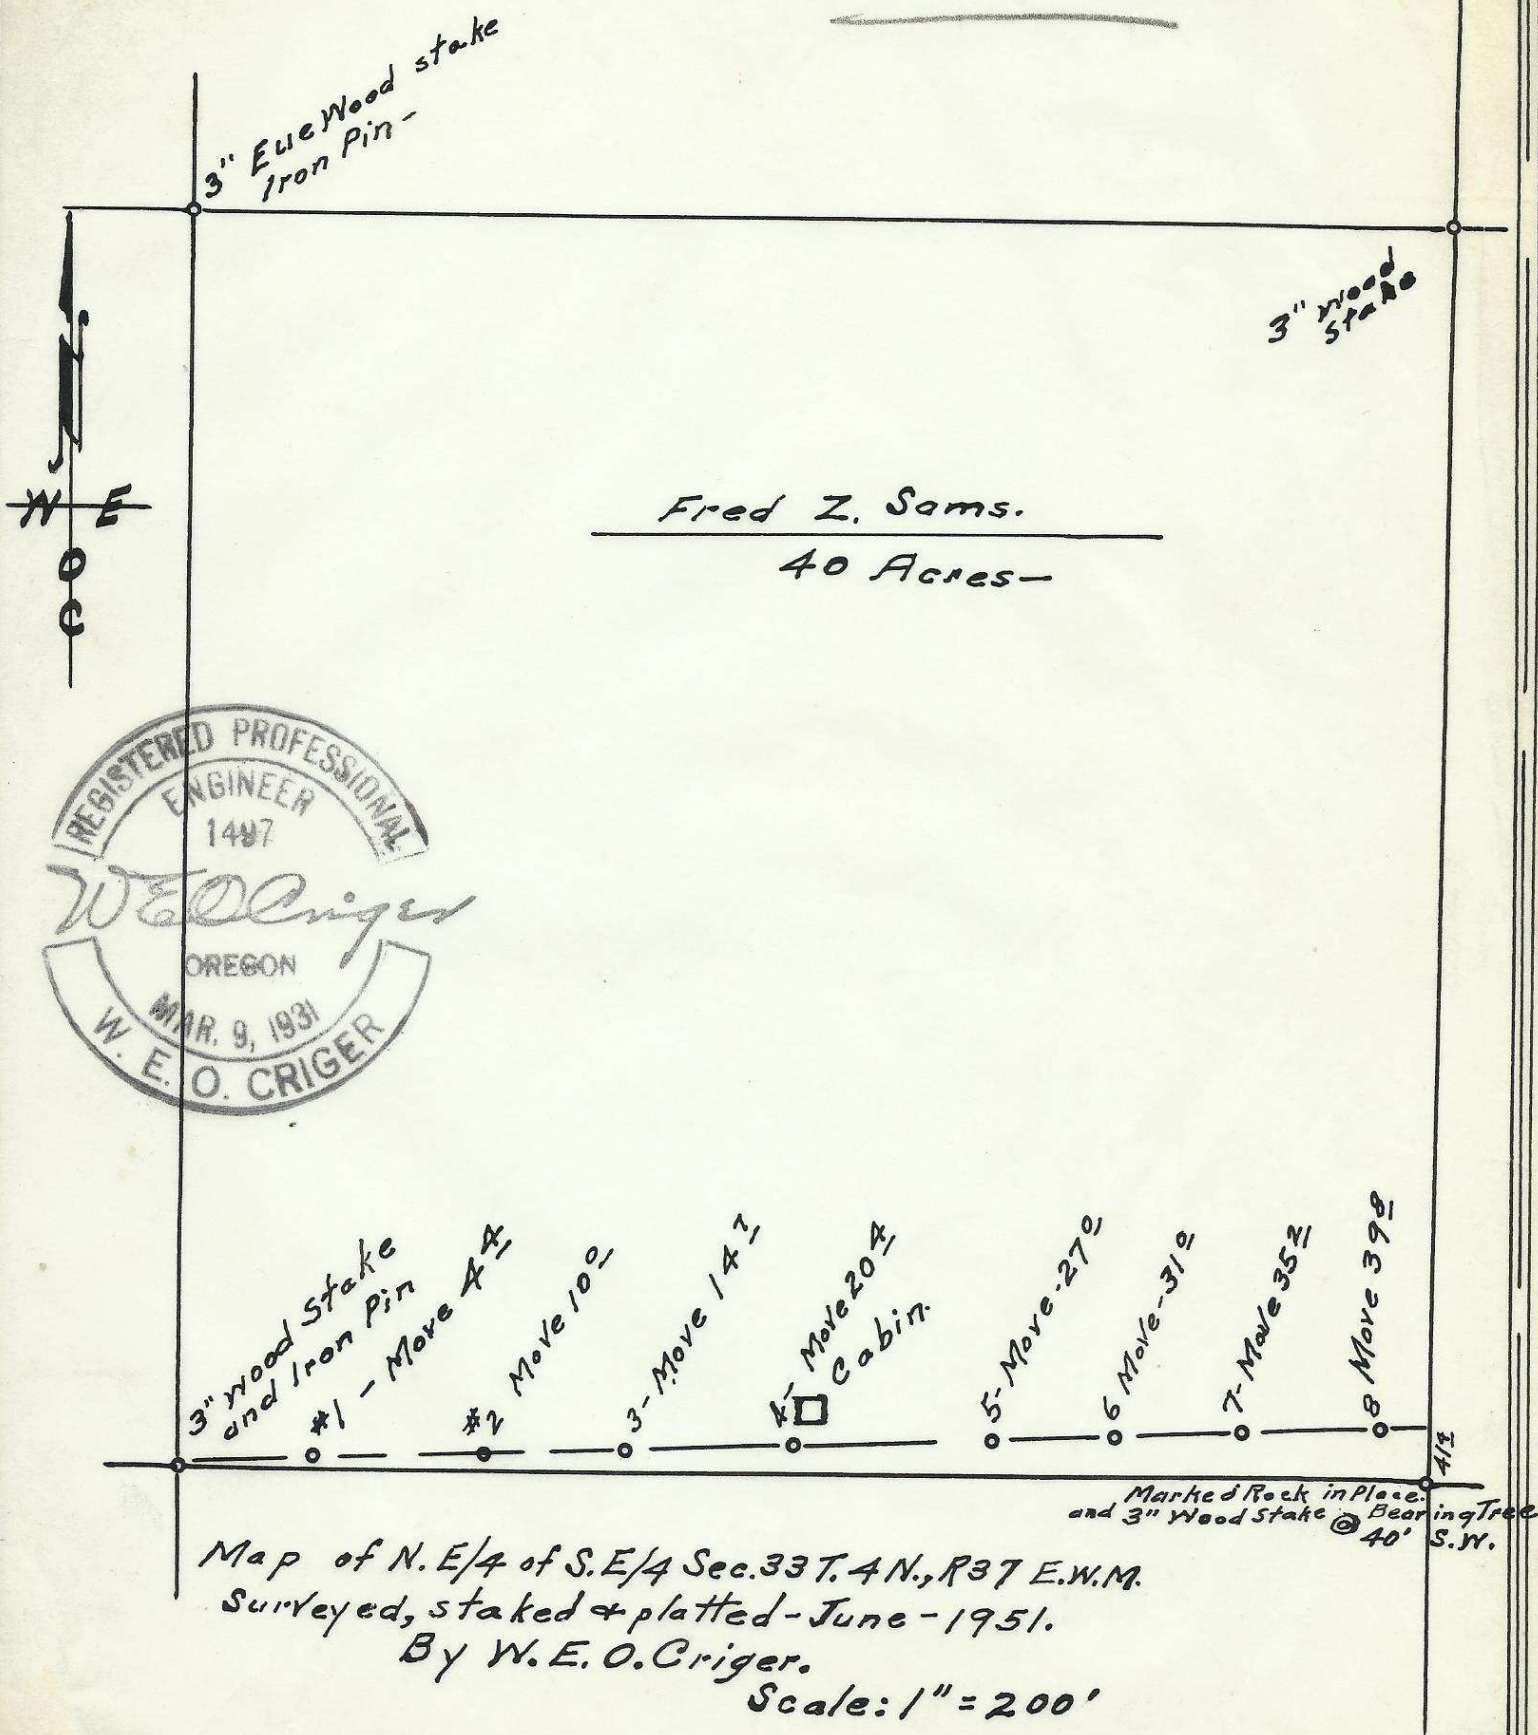

Map of N. E/4 of S. E/4 Sec. 33 T. 4 N., R 37 E. W. M.  
Surveyed, staked & platted - June - 1951.  
By W. E. O. Criger.  
Scale: 1" = 200'

06-103-Ax