


S.W. Isaac Ave.

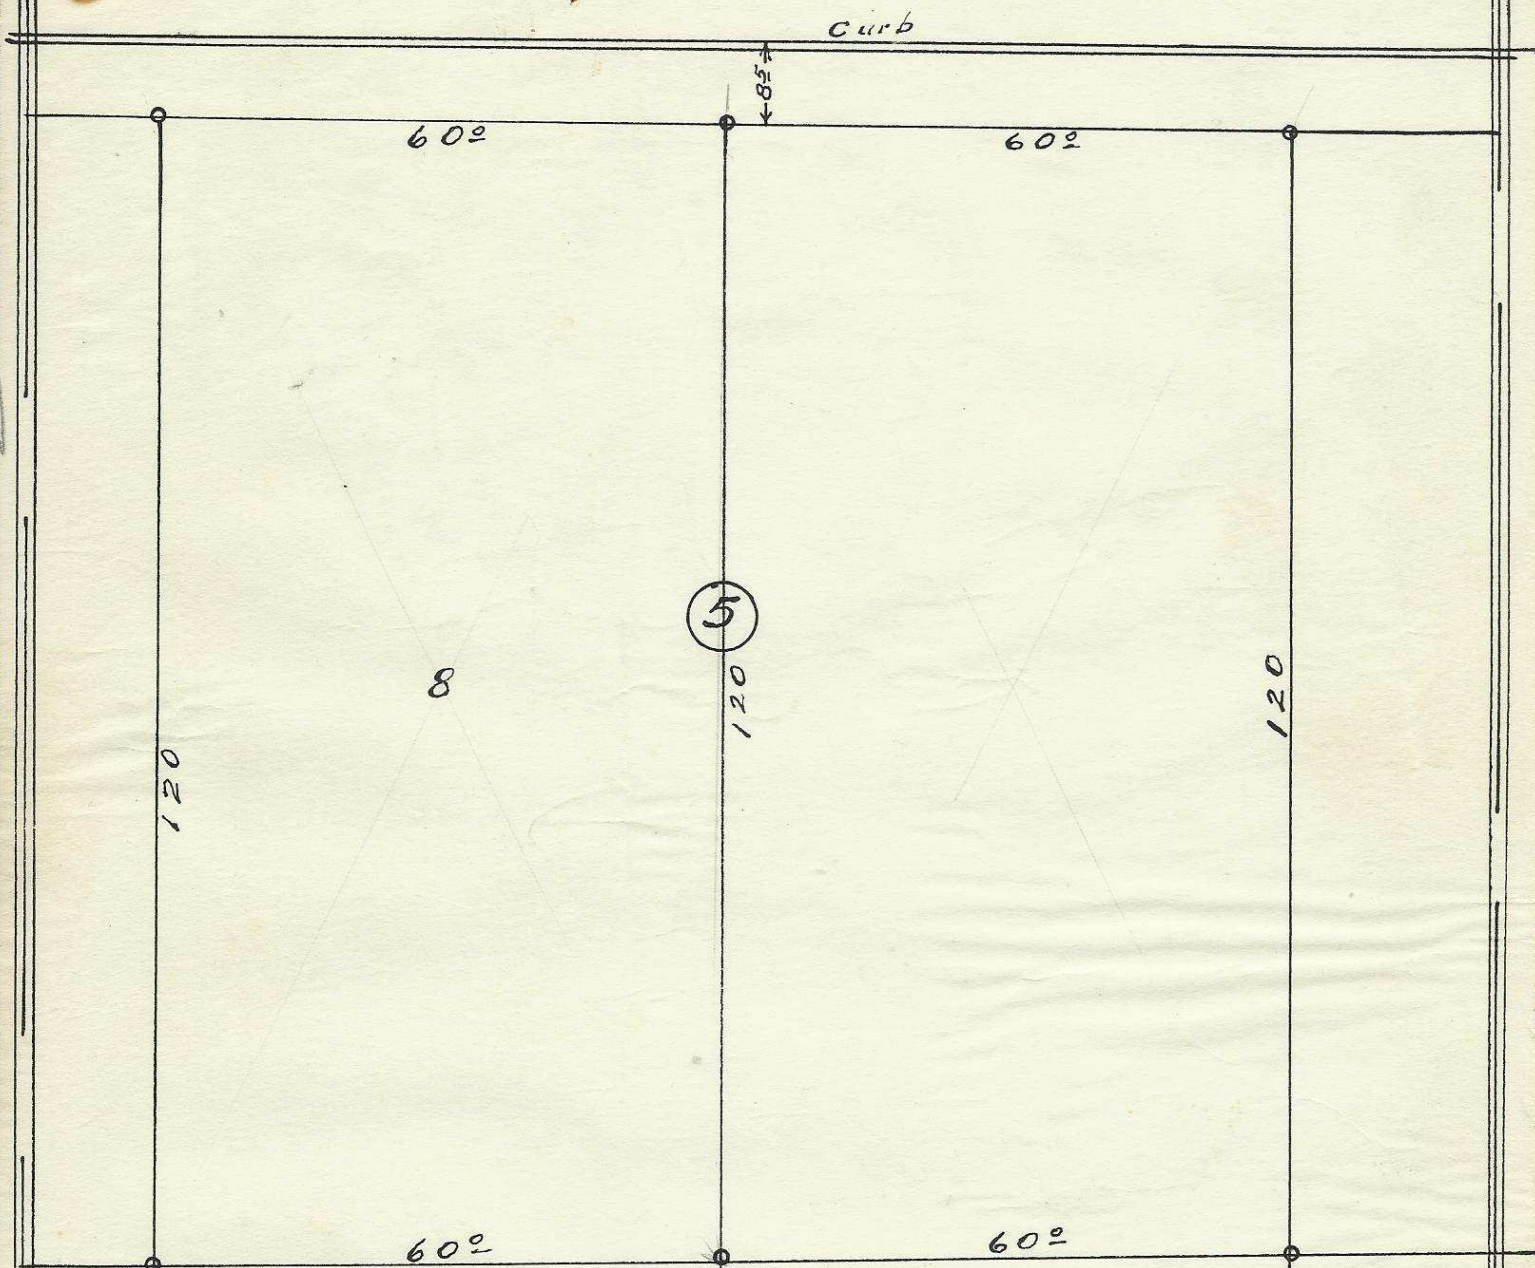

2N3216AB
Plat showing
Lot 8 of Block 5 of
Sherwood Heights Addition to
The City of Pendleton, Ore.
Surreyed, staked + platted Sept. 1955
By W. E. O. Criger.
06-120-A8 Scale: 1 inch = 20 Feet. (4)