


S. E. Dorian Ave.

S. E. 6th St

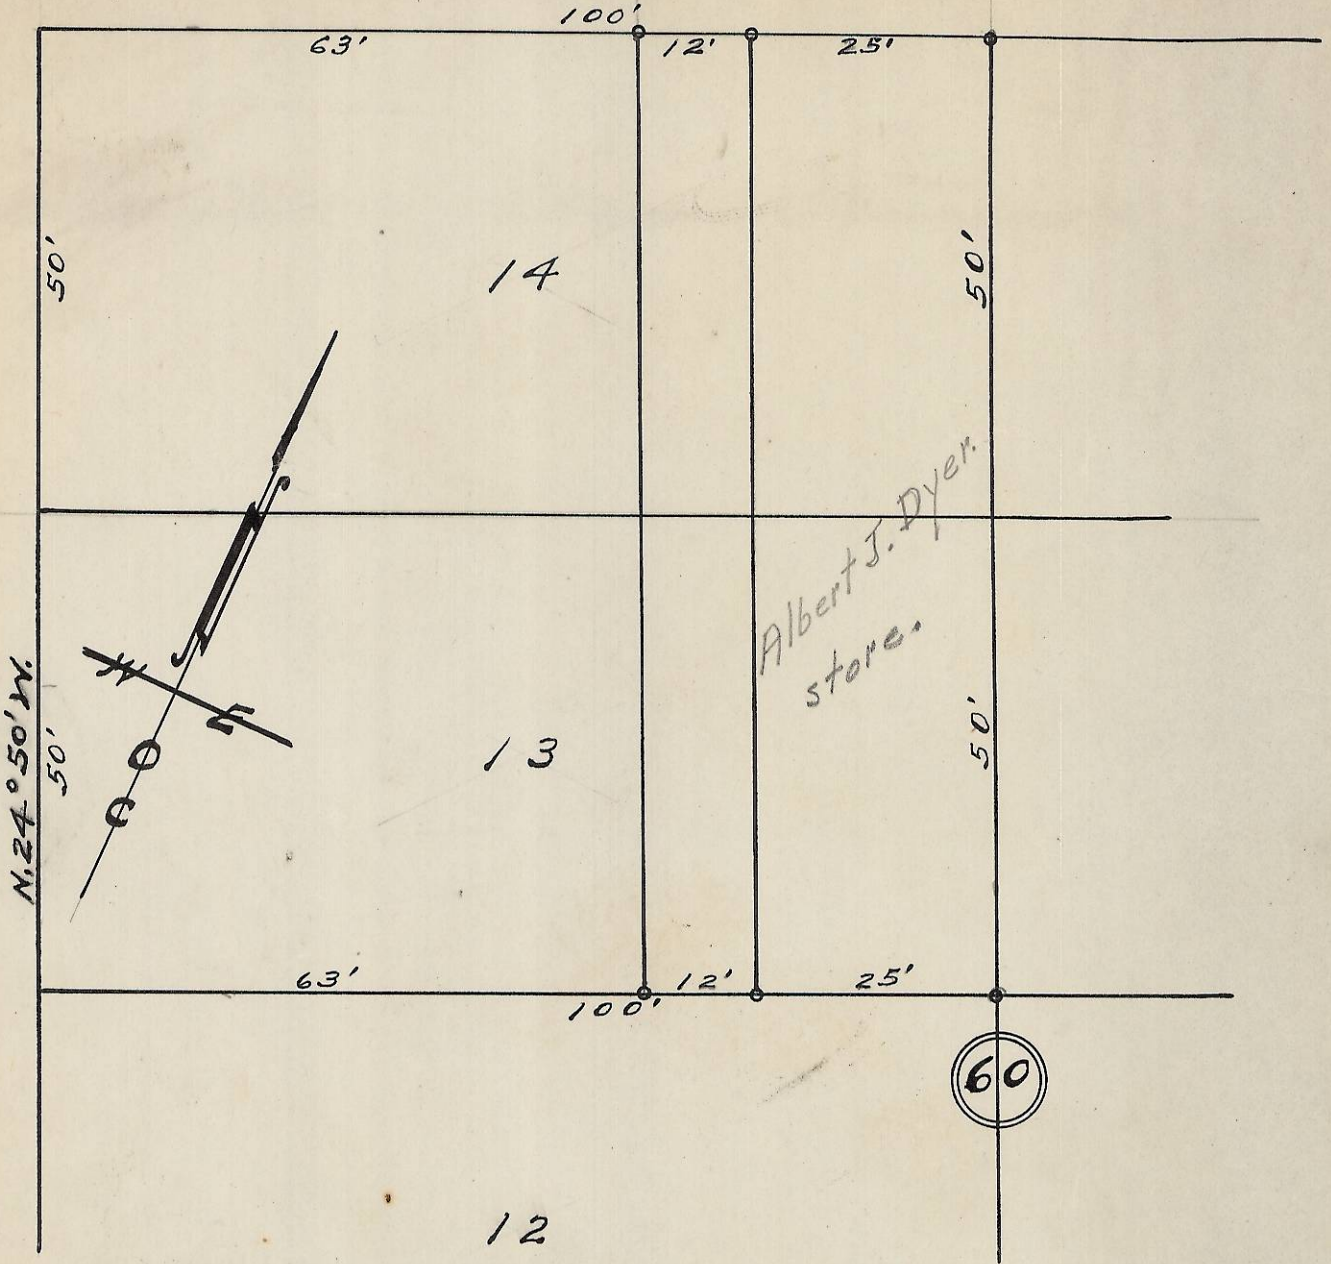

Plat showing  
 Lots 13 & 14 of Block 60 of  
 Reservation Addition  
 To the City of Pendleton, Ore.,  
 surveyed, staked & platted July-1953.  
 By W. E. O. Criger. Scale: 1" = 20'

06-356-Ax