


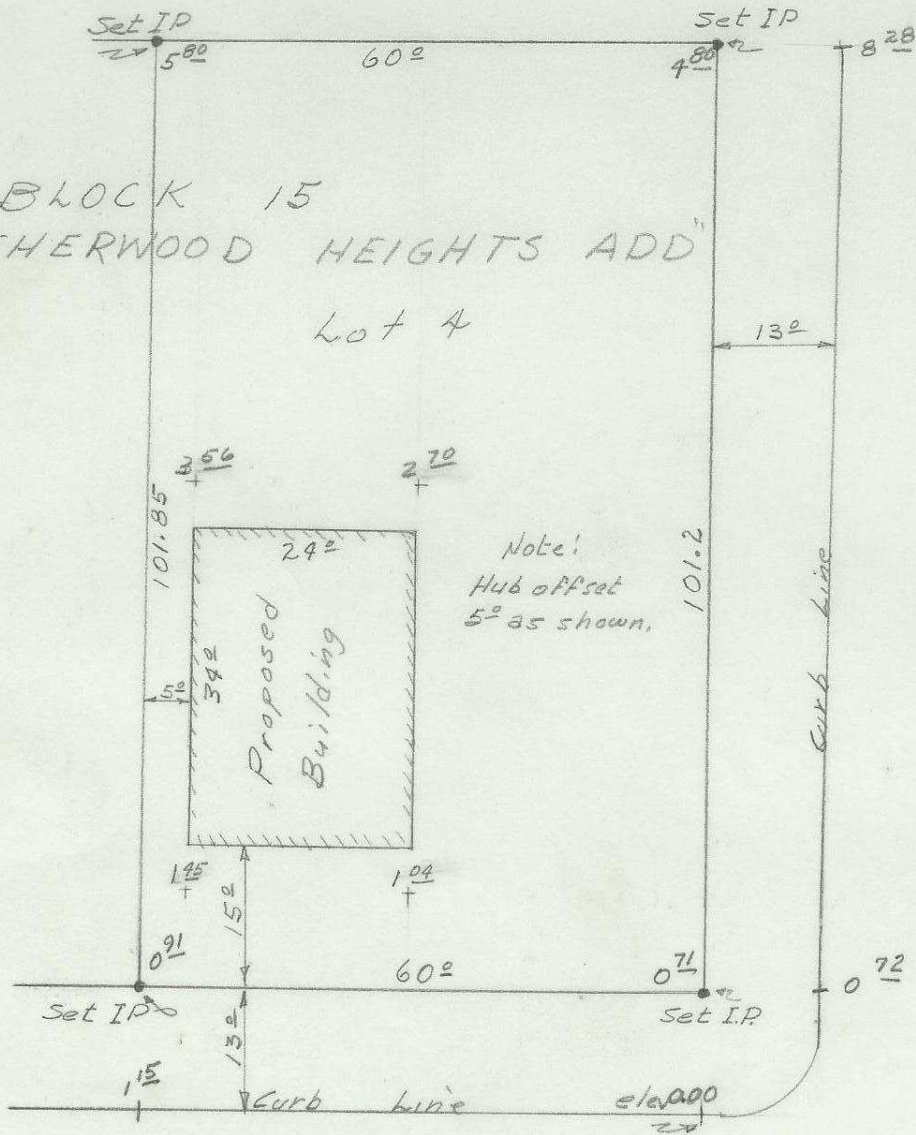

BLOCK 15  
"SHERWOOD HEIGHTS ADD"  
Lot 4



S.W. LADDER

S.W. 28<sup>th</sup> St.

RN 32 16 AD

SCALE: 1" = 20 Ft	DATE: Nov 29, 56
WALL AND TENNESON Engineers	
The Dalles	Oregon

06-421-A8