

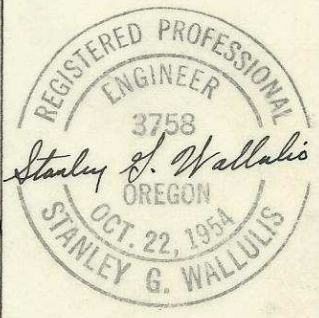


TWN. 5 NORTH

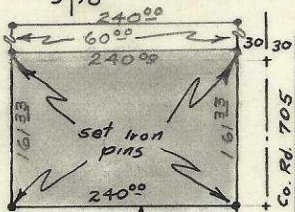


TWN. 4 NORTH
R 28 EWM

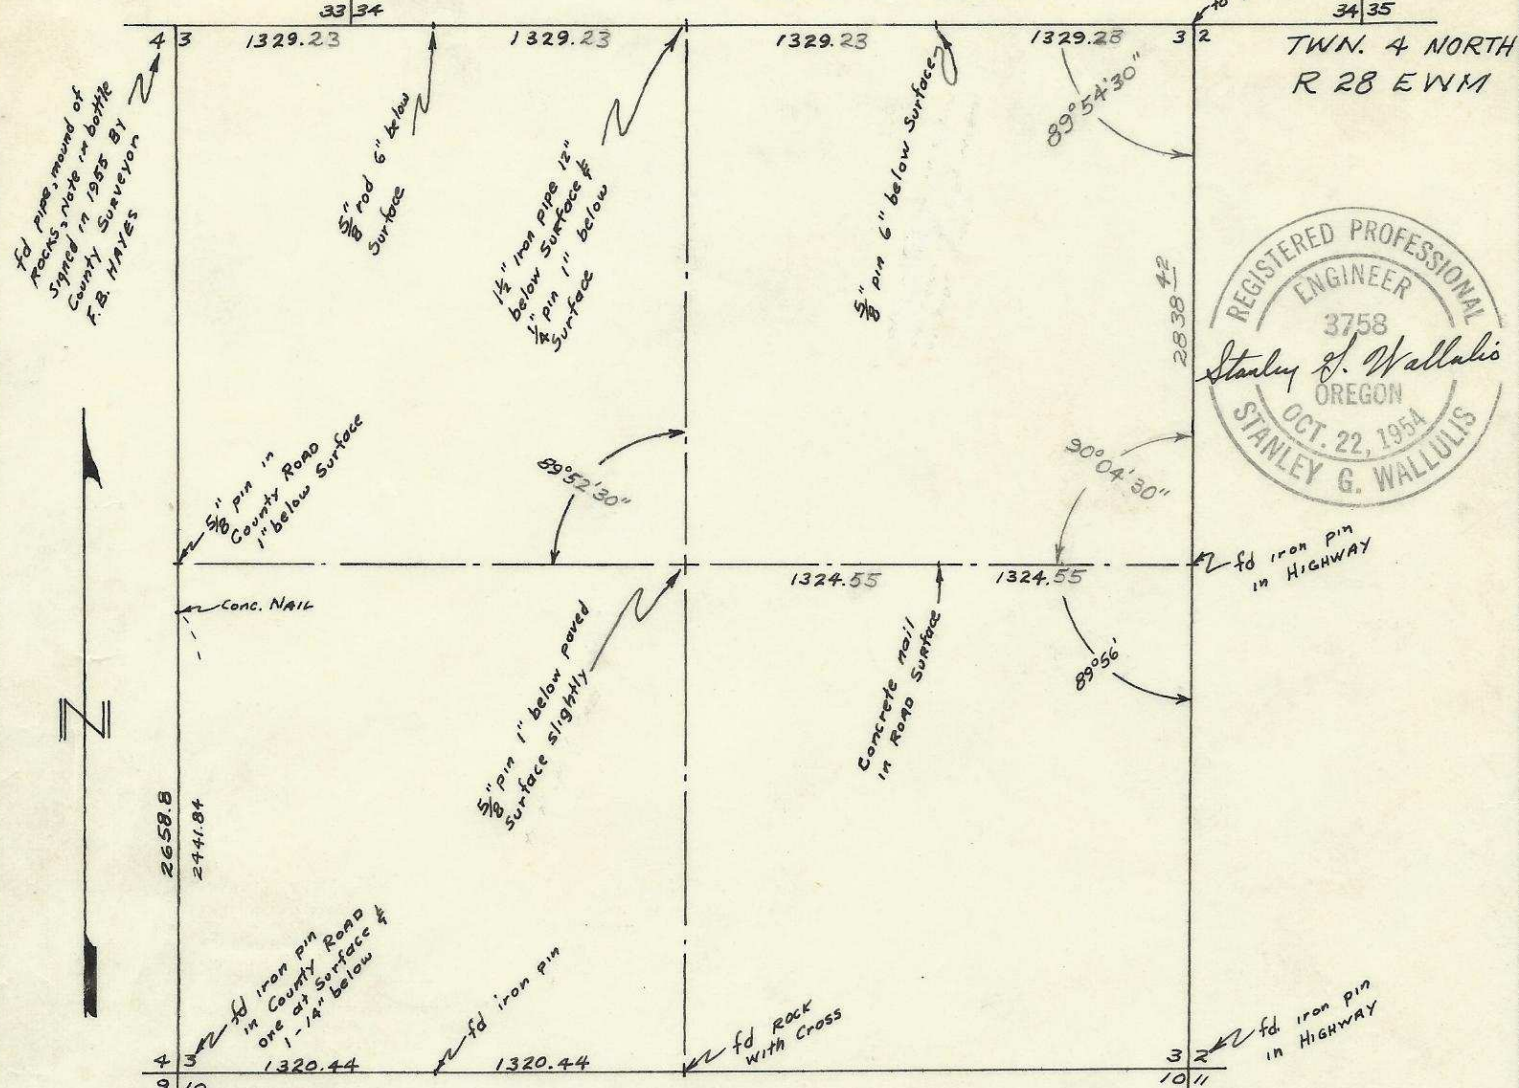

SURVEY FOR SAM GODWIN
Scale 1" = 200'

SURVEY FOR W. HOFFMAN & R. ARMSTRONG
Scale 1" = 200'

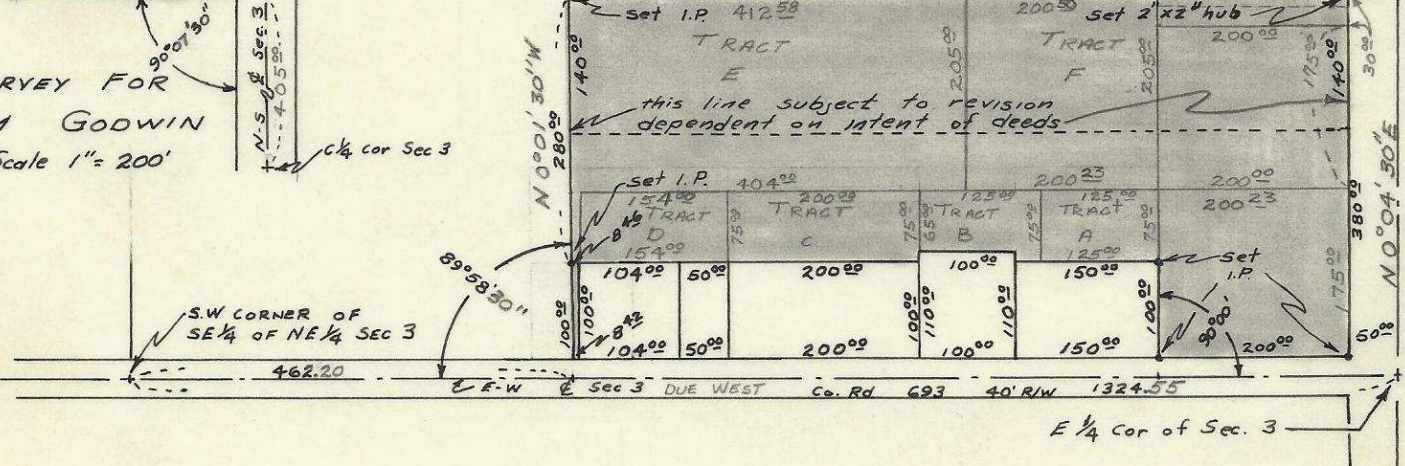

SURVEY IN SEC. 3, TWN 4N., R.28 E.W.M.

Date: MARCH 8, 1963
Rev. MAY 20, 1965

06-429-AX