


H-69-Ax

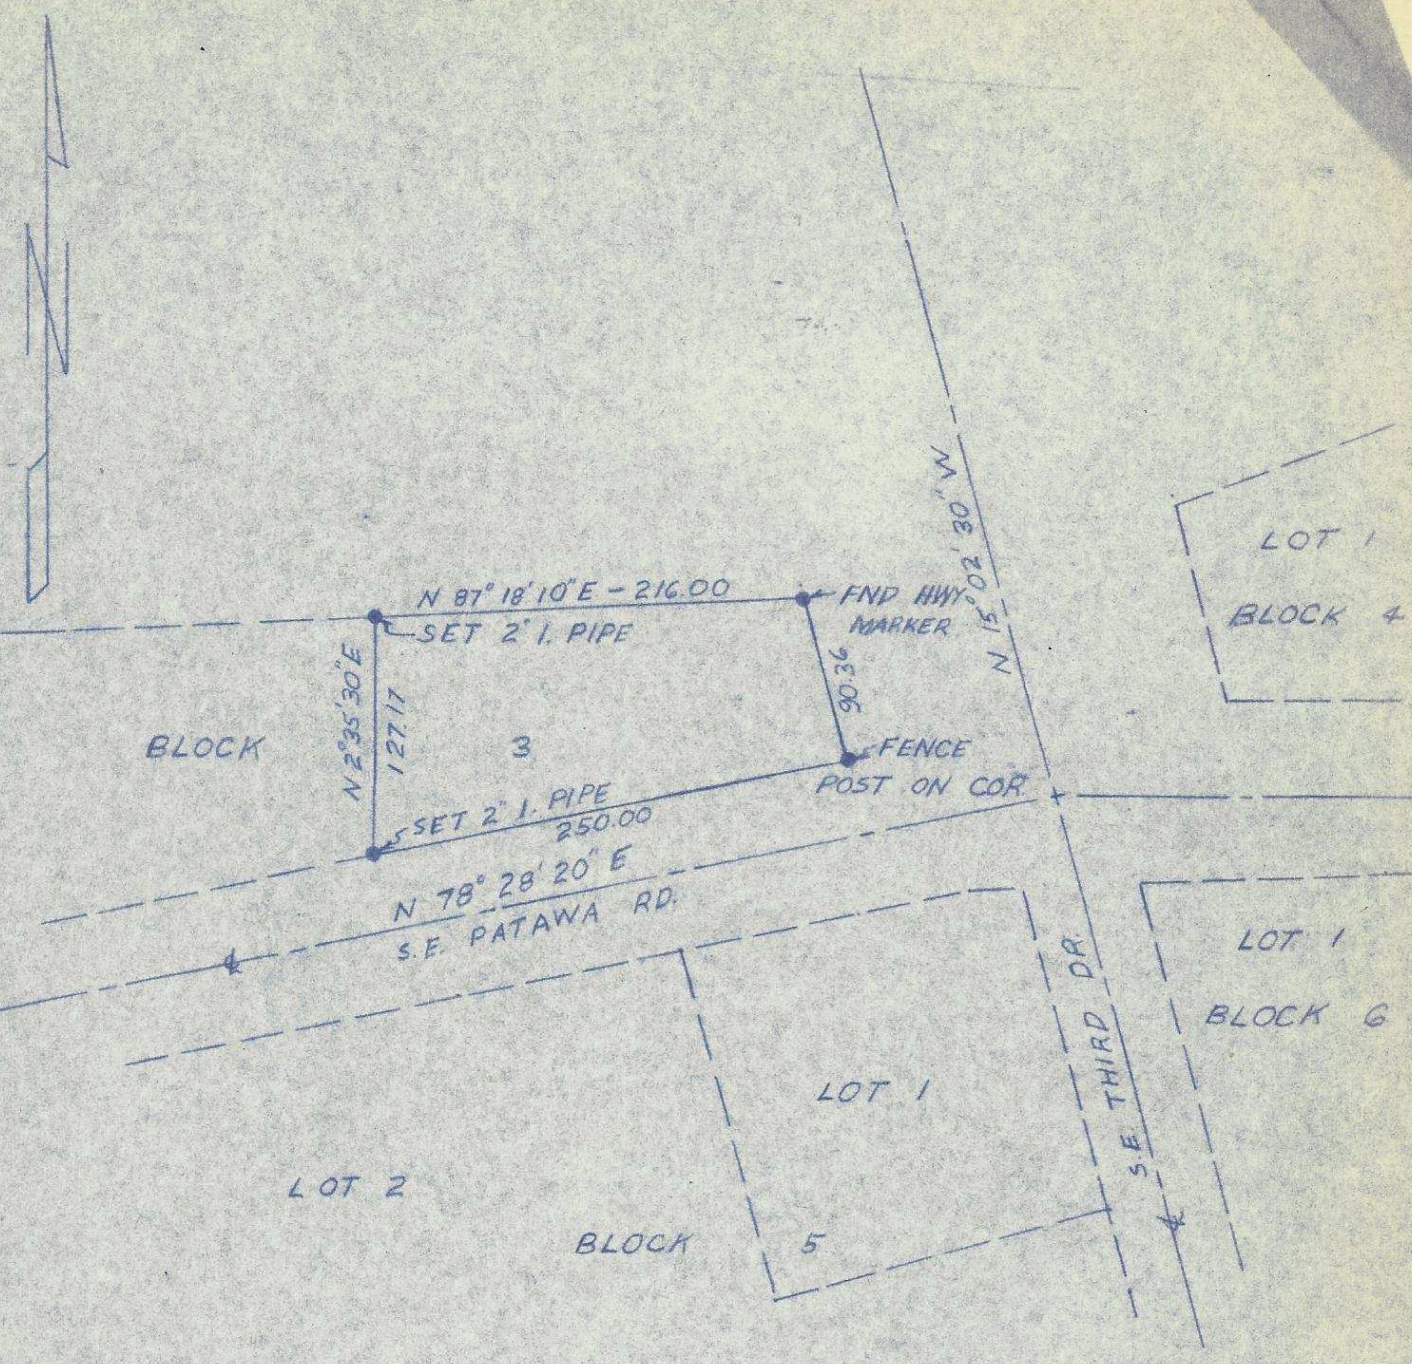

REGISTERED
 OREGON
 LAND SURVEYOR

David W. Krumbein

JULY 17, 1970
 DAVID H. KRUMBEIN
 933

203211C

WAYNE O. HARRIS & ASSOCIATES

SURVEY FOR
 ATLANTIC RICHFIELD COMPANY
 PARCEL IN BLOCK 3, REES ADDITION
 PENDLETON, OREGON

SCALE	DATE	DRWN BY	DRNG No.
1"=100'	1-29-71	DHK	71-346

06-613-Ax